


1) LOCATION OF WATER WELL: County: GEARY Fraction:  $\frac{1}{4}$  NE  $\frac{1}{4}$  NE  $\frac{1}{4}$  Section Number: 7 Township Number: T 12 S Range Number: R 5 E

Distance and direction from nearest town or city street address of well if located within city? From Grandview Plaza 60 to South on Hill Road

2) WATER WELL OWNER: Arnold Glessner  
 RR#, St. Address, Box #: RR 5 Box 3A  
 City, State, ZIP Code: Junction City Kan 66441  
 Board of Agriculture, Division of Water Resources  
 Application Number:

3) LOCATE WELL'S LOCATION WITH AN "X" IN SECTION BOX:

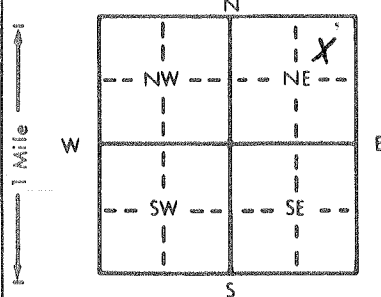

4) DEPTH OF COMPLETED WELL: 120 ft. ELEVATION: \_\_\_\_\_ ft.

Depth(s) Groundwater Encountered 1. \_\_\_\_\_ ft. 2. \_\_\_\_\_ ft. 3. \_\_\_\_\_ ft.  
 WELL'S STATIC WATER LEVEL: 70.85 ft. below land surface measured on mo/day/yr \_\_\_\_\_  
 Pump test data: Well water was \_\_\_\_\_ ft. after \_\_\_\_\_ hours pumping \_\_\_\_\_ gpm  
 Est. Yield: 7 gpm: Well water was \_\_\_\_\_ ft. after \_\_\_\_\_ hours pumping \_\_\_\_\_ gpm  
 Bore Hole Diameter: 8 in. to 120 ft., and \_\_\_\_\_ in. to \_\_\_\_\_ ft.  
 WELL WATER TO BE USED AS:  
 1 Domestic  3 Feedlot  6 Oil field water supply  9 Dewatering  12 Other (Specify below)  
 2 Irrigation  4 Industrial  7 Lawn and garden only  10 Monitoring well  
 Was a chemical/bacteriological sample submitted to Department? Yes \_\_\_\_\_ No  If yes, mo/day/yr sample was submitted \_\_\_\_\_  
 Water Well Disinfected?  Yes  No

5) TYPE OF BLANK CASING USED:  
 1 Steel  3 RMP (SR)  6 Asbestos-Cement  9 Other (specify below)  
 2 PVC  4 ABS  7 Fiberglass \_\_\_\_\_  
 CASING JOINTS:  Glued  Welded  Clamped \_\_\_\_\_  
 Threaded \_\_\_\_\_

Blank casing diameter: 5 in. to 100 ft., Dia \_\_\_\_\_ in. to \_\_\_\_\_ ft., Dia \_\_\_\_\_ in. to \_\_\_\_\_ ft.  
 Casing height above land surface: 24 in., weight Sub. 40 lbs./ft. Wall thickness or gauge No. \_\_\_\_\_

TYPE OF SCREEN OR PERFORATION MATERIAL:  
 1 Steel  3 Stainless steel  5 Fiberglass  7 PVC  10 Asbestos-cement  
 2 Brass  4 Galvanized steel  6 Concrete tile  9 ABS  11 Other (specify) \_\_\_\_\_  
 12 None used (open hole)

SCREEN OR PERFORATION OPENINGS ARE:  
 1 Continuous slot  3 Mill slot 31/1000  5 Gauzed wrapped  8 Saw cut  11 None (open hole)  
 2 Louvered shutter  4 Key punched  6 Wire wrapped  9 Drilled holes  
 7 Torch cut  10 Other (specify) \_\_\_\_\_

SCREEN-PERFORATED INTERVALS: From 100 ft. to 120 ft., From \_\_\_\_\_ ft. to \_\_\_\_\_ ft.  
 From \_\_\_\_\_ ft. to \_\_\_\_\_ ft., From \_\_\_\_\_ ft. to \_\_\_\_\_ ft.  
 GRAVEL PACK INTERVALS: From 20 ft. to 120 ft., From \_\_\_\_\_ ft. to \_\_\_\_\_ ft.  
 From \_\_\_\_\_ ft. to \_\_\_\_\_ ft., From \_\_\_\_\_ ft. to \_\_\_\_\_ ft.

6) GROUT MATERIAL:  1 Neat cement  2 Cement grout  3 Bentonite  4 Other \_\_\_\_\_  
 Grout Intervals: From 0 ft. to 20 ft., From \_\_\_\_\_ ft. to \_\_\_\_\_ ft., From \_\_\_\_\_ ft. to \_\_\_\_\_ ft.

What is the nearest source of possible contamination:  
 1 Septic tank  4 Lateral lines  7 Pit privy  10 Livestock pens  14 Abandoned water well  
 2 Sewer lines  5 Cess pool  8 Sewage lagoon  11 Fuel storage  15 Oil well/Gas well  
 3 Watertight sewer lines  6 Seepage pit  9 Feedyard  12 Fertilizer storage  16 Other (specify below)  
 13 Insecticide storage \_\_\_\_\_  
 Direction from well? West How many feet? 200

FROM	TO	LITHOLOGIC LOG	FROM	TO	PLUGGING INTERVALS
0	2	GRAVEL	57	65	GRAY SHALE
2	5	BROWN CLAY	65	66	LIMESTONE
5	8	TAN CLAY	66	75	GRAY SHALE
8	10	LIMESTONE	75	82	LIMESTONE
10	12	TAN CLAY	82	85	GRAY SHALE
12	22	GRAY SHALE	85	90	LIMESTONE
22	23	GRAY Limestone	90	95	SHALE GRAY
23	35	TAN Limestone	95	120	Limestone
35	37	GRAY SHALE			
37	38	Limestone			
38	41	GRAY SHALE			
41	45	RED SHALE			
45	47	Limestone			
47	55	TAN SHALE			
55	57	Limestone			

7) CONTRACTOR'S OR LANDOWNER'S CERTIFICATION: This water well was  (1) constructed,  (2) reconstructed, or  (3) plugged under my jurisdiction and was completed on (mo/day/year) 7/31/89 and this record is true to the best of my knowledge and belief. Kansas Water Well Contractor's License No. 451 This Water Well Record was completed on (mo/day/yr) 8/29/89 under the business name of Haldeman well Drilling by (signature) Craig H