

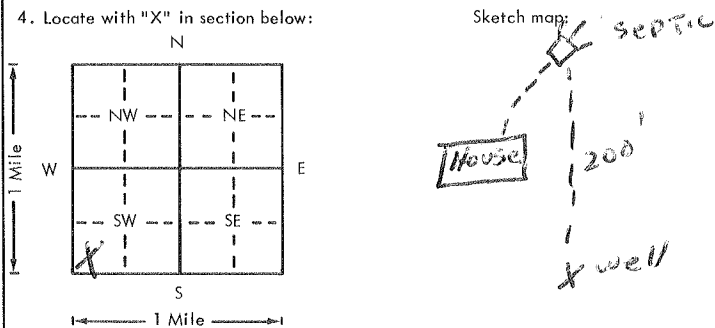
USE TYPEWRITER OR BALL POINT PEN-PRESS FIRMLY, PRINT CLEARLY.

WATER WELL RECORD
KSA 82a-1201-1215

Kansas Department of Health and Environment-Division of Environment
(Water well Contractors)
Topeka, Kansas 66620

1. Location of well: County Greary Fraction SW 1/4 SW 1/4 SW 1/4 Section number 9 Township number T 12 S Range number R 5 E/W

2. Distance and direction from nearest town or city: 2 W 1/2 S S of **3. Owner of well:** Richard Rothfus
Street address of well location if in city: JUNCTION CITY R.R. or street: RT 3 Box 138
City, state, zip code: JUNCTION CITY RR 3

4. Locate with "X" in section below: Sketch map: septic

6. Bore hole dia. 8 in. Completion date 9-30-78
Well depth 200 ft.
7. Cable tool Rotary Driven Dug
 Hollow rod Jetted Bored Reverse rotary
8. Use: Domestic Public supply Industry
 Irrigation Air conditioning Stock
 Lawn Oil field water Other
9. Casing: Material PVC Height: Above or below
Threaded Welded Surface 29 in.
RMP PVC 96 Weight 2.58 lbs./ft.
Dia. 5 in. to 30 ft. depth Wall Thickness: inches or
Dia. 5 in. to 30 ft. depth gage No. 1279

5. Type and color of material	From	To
<u>Top soil</u>	<u>0</u>	<u>4</u>
<u>Clay, Brown</u>	<u>4</u>	<u>12</u>
<u>Shale, grey, Limestone, Brown</u>	<u>12</u>	<u>75</u>
<u>Shale, Limestone, Brown</u>	<u>75</u>	<u>129</u>
<u>Limestone, yellow</u>	<u>129</u>	<u>132</u>
<u>Shale, grey, Limestone, grey</u>	<u>132</u>	<u>169</u>
<u>Limestone, grey Brown</u>	<u>169</u>	<u>170</u>
<u>Shale, grey</u>	<u>170</u>	<u>200</u>

10. Screen: Manufacturer's name Pumpco MBE
Type PVC Dia. 5
Slot/gauze .020 Length 20
Set between 120 ft. and 140 ft.
160 ft. and 180 ft.
Gravel pack? Size range of material 20-40 mesh

11. Static water level: 130 ft. below land surface Date 9-30-78 mo./day/yr.

12. Pumping level below land surfaces:
 ft. after hrs. pumping g.p.m.
 ft. after hrs. pumping g.p.m.
Estimated maximum yield 6 g.p.m.

13. Water sample submitted: mo./day/yr.
 Yes No Date

14. Well head completion: CAP
 Pitless adapter 29 Inches above grade

15. Well grouted?
With: Neat cement Bentonite Concrete
Depth: From 5 ft. to 15 ft.

16. Nearest source of possible contamination:
ft. 200 Direction N Type septic
Well disinfected upon completion? Yes No

17. Pump: Not installed
Manufacturer's name
Model number HP Volts
Length of drop pipe ft. capacity g.p.m.
Type:
 Submersible Turbine
 Jet Reciprocating
 Centrifugal Other

(Use a second sheet if needed)

18. Elevation: Topography: Hill Slope Upland Valley

19. Remarks: OWNER TO INSTALL SLAB

20. Water well contractor's certification:
This well was drilled under my jurisdiction and this report is true to the best of my knowledge and belief.
Strader Dale Co Inc 182
Business name License No.
Address RT 1 Holton KS
Signed Dale Ashburn Date 5-2-79
Authorized representative

Forward the white, blue and pink copies to the Department of Health and Environment

Form WWC-5