USE TYPEWRITER OR BALL POINT PEN-PRESS FIRMLY, PRINT CLEARLY.

WATER WELL RECORD
KSA 82a-1201-1215

Kansas Department of Health and Environment-Division of Environment
(Water well Contractors)
Topeka, Kansas 66620

1. Location of well:	County	Fraction	Section number	Township number	Range number
	GEARY	NW 1/4 SE 1/4 SW 1/4	9	T 12S S	R 5 EAST E/W

2. Distance and direction from nearest town or city: 2 Miles West of Junction City Kansas
Street address of well location if in city:

3. Owner of well: Stone Copper Hoffee
R.R. or street: #1
City, state, zip code: Junction City Kansas

4. Locate with "X" in section below:

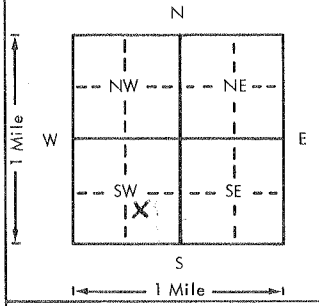

Sketch map:

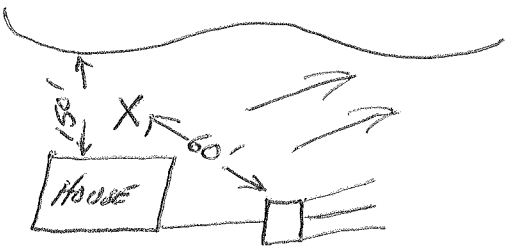

6. Bore hole dia. 9" in. Completion date 4-3-78
Well depth 65' ft.

7. ___ Cable tool X Rotary ___ Driven ___ Dug
___ Hollow rod ___ Jetted ___ Bored ___ Reverse rotary

8. Use: X Domestic ___ Public supply ___ Industry
___ Irrigation ___ Air conditioning ___ Stock
___ Lawn ___ Oil field water ___ Other

9. Casing: Material PLS Height: (Above) or below
Threaded ___ Welded GL Surface 18" in.
RMP X PVC ___ Weight ___ lbs./ft.
Dia. 5 in. to 46 ft. depth Wall Thickness: inches or
Dia. ___ in. to ___ ft. depth gage No. 1200

5. Type and color of material	From	To
SAND Medium	0	12
Sandy SHALE Gray	12	21
SHALE Some SAND Stone	21	26
LIME Broken	26	32
SHALE Blue	32	36
LIME Tan	36	38
SHALE Gray	38	41
LIME White	41	45
SHALE Gray	45	46
LIME Broken	46	51
LIME With FLINT	51	65

(Use a second sheet if needed)

10. Screen: Manufacturer's name SWAF-Loskin Plastic Pipe
Type RMP Dia. 5"
(Slot) gauze 1/8 Length 19'
Set between 46 ft. and 65 ft.
___ ft. and ___ ft.
Gravel pack? Yes Size range of material 4 to 5/8

11. Static water level: mo./day/yr.
46 ft. below land surface Date 4-3-78

12. Pumping level below land surfaces:
___ ft. after ___ hrs. pumping ___ g.p.m.
___ ft. after ___ hrs. pumping ___ g.p.m.
Estimated maximum yield 10 g.p.m.

13. Water sample submitted: mo./day/yr.
___ Yes X No Date

14. Well head completion:
___ Pitless adapter 18" Inches above grade

15. Well grouted? ___
With: X Neat cement ___ Bentonite ___ Concrete
Depth: From 4 ft. to 14 ft.

16. Nearest source of possible contamination:
ft. 60 Direction SE Type Septic
Well disinfected upon completion? X Yes ___ No

17. Pump: X Not installed
Manufacturer's name ___
Model number ___ HP ___ Volts ___
Length of drop pipe ___ ft. capacity ___ g.p.m.
Type:
___ Submersible ___ Turbine
___ Jet ___ Reciprocating
___ Centrifugal ___ Other

18. Elevation:

Topography:
___ Hill
___ Slope
X Upland
___ Valley

19. Remarks:
Concrete Slab To Be Installed By Customer
Stephen Koppenhoffer

20. Water well contractor's certification:
This well was drilled under my jurisdiction and this report is true to the best of my knowledge and belief.
Zinn Water Well Drilling 210
Business name License No.
Address Lost Springs, Kan
Signed Joseph A. Zinn Date 4-10-78
Authorized representative

T 12 — R 5 E/W — Sec 9 — 1/4 NW 1/4 SE 1/4 SW 1/4

Forward the white, blue and pink copies to the Department of Health and Environment

Form WWC-5

MI-1023