USE TYPEWRITER OR BALL POINT PEN-PRESS FIRMLY, PRINT CLEARLY.

WATER WELL RECORD
KSA 82a-1201-1215

Kansas Department of Health and Environment-Division of Environment
(Water well Contractors)
Topeka, Kansas 66620

CW½ SW NE

1. Location of well:	County	Fraction	Section number	Township number	Range number
	GEARY	~~SE~~ 1/4 ~~NE~~ 1/4 1/4	10	T 12 S	R 5 E E/W

2. Distance and direction from nearest town or city: ½ M. West of Junction City
Street address of well location if in city:

3. Owner of well: David S Walker
R.R. or street: 934 Mulberry
City, state, zip code: Junction City Kans

4. Locate with "X" in section below:

Sketch map:

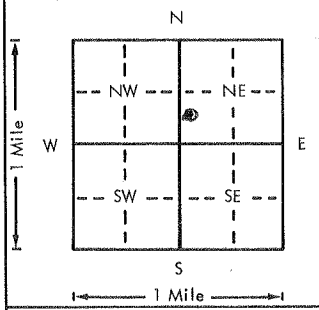

6. Bore hole dia. 8 in. Completion date 1-3-76
Well depth 203 ft.

7. X Cable tool ___ Rotary ___ Driven ___ Dug
___ Hollow rod ___ Jetted ___ Bored ___ Reverse rotary

8. Use: X Domestic ___ Public supply ___ Industry
___ Irrigation ___ Air conditioning ___ Stock
___ Lawn ___ Oil field water ___ Other

9. Casing: Material RMP Height: Above or below
Threaded ___ Welded ___ Surface 2.0 in.
RMP ✓ PVC ___ Weight 250 lbs./ft.
Dia. 5 in. to 203 ft. depth Wall Thickness: inches or
Dia. ___ in. to ___ ft. depth gage No. Sch 40 MHS

10. Screen: Manufacturer's name Jass + Lowell
Type RMP Dia. 5"
Slot/gauze ¼ Length 40'
Set between 80 ft. and 120 ft.
___ ft. and ___ ft.
Gravel pack? ✓ Size range of material 4 X ¼

11. Static water level: mo./day/yr.
90 ft. below land surface Date 1-3-76
Bucket test

12. Pumping level below land surfaces:
___ ft. after ___ hrs. pumping ___ g.p.m.
___ ft. after ___ hrs. pumping ___ g.p.m.
Estimated maximum yield 3½ g.p.m.

13. Water sample submitted: mo./day/yr.
___ Yes X No Date

14. Well head completion: not installed
___ Pitless adapter ___ Inches above grade

15. Well grouted? ✓
With: ___ Neat cement ✓ Bentonite ___ Concrete
Depth: From 5 ft. to 16 ft.

16. Nearest source of possible contamination:
ft. 300 Direction east Type House
Well disinfected upon completion? X Yes MHC No

17. Pump: ✓ Not installed
Manufacturer's name
Model number HP Volts
Length of drop pipe ft. capacity g.p.m.
Type:
___ Submersible ___ Turbine
___ Jet ___ Reciprocating
___ Centrifugal ___ Other

5. Type and color of material

	From	To
Top soil	0	4
Yellow Limestone	4	45
Blue Shale	45	49
Yellow limestone	49	78
Blue Shale	78	101
Red Shale	101	110
Limestone	110	120
Red Shale	120	155
Blue Shale	155	170
Blue Shale	170	203

(Use a second sheet if needed)

18. Elevation:

Topography:
✓ Hill
___ Slope
___ Upland
___ Valley

19. Remarks:

20. Water well contractor's certification:
This well was drilled under my jurisdiction and this report is true to the best of my knowledge and belief.
Strader Drilling Co 237
Business name License No.
Address Blue Rapids
Signed Harold Strader Date 1-3
Authorized representative

T 12 R 5 E Sec 10 CW½ SW NE 1/4 1/4 1/4 76

Forward the white, blue and pink copies to the Department of Health and Environment

Form WWC-5

MI-1023