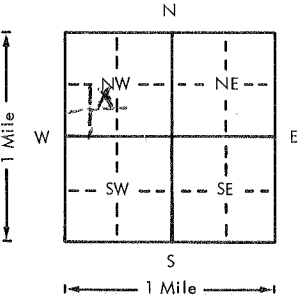


USE TYPEWRITER OR BALL POINT PEN-PRESS FIRMLY, PRINT CLEARLY.

WATER WELL RECORD  
KSA 82a-1201-1215

Kansas Department of Health and Environment-Division of Environment  
(Water well Contractors)  
Topeka, Kansas 66620

1. Location of well:		County <b>R Geary</b>	Fraction <b>NE 1/4 SW 1/4 NW 1/4</b>	Section number <b>X 11</b>	Township number <b>T 12 S</b>	Range number <b>R 5</b>	<b>(EW)</b>
2. Distance and direction from nearest town or city: Street address of well location if in city:				3. Owner of well: Kenneth Christian R.R. or street: Meadowlane Ave. City, state, zip code: Junction City, Kansas			
4. Locate with "X" in section below: Sketch map: 			6. Bore hole dia. <u>8</u> in. Completion date <u>10-13-76</u> Well depth <u>212</u> ft.		7. <input type="checkbox"/> Cable tool <input checked="" type="checkbox"/> Rotary <input type="checkbox"/> Driven <input type="checkbox"/> Dug <input type="checkbox"/> Hollow rod <input type="checkbox"/> Jetted <input type="checkbox"/> Bored <input type="checkbox"/> Reverse rotary		
5. Type and color of material			From	To	8. Use: <input type="checkbox"/> Domestic <input type="checkbox"/> Public supply <input type="checkbox"/> Industry <input checked="" type="checkbox"/> Irrigation <input type="checkbox"/> Air conditioning <input type="checkbox"/> Stock <input type="checkbox"/> Lawn <input type="checkbox"/> Oil field water <input type="checkbox"/> Other		
Clay			0	10	9. Casing: Material <u>plst</u> Height: Above or below Threaded <input type="checkbox"/> Welded <input checked="" type="checkbox"/> Surface <u>18</u> in. RMP <input checked="" type="checkbox"/> PVC <input type="checkbox"/> Weight _____ lbs./ft. Dia. <u>5</u> in. to <u>121</u> ft. depth Wall Thickness: inches or Dia. _____ in. to _____ ft. depth gage No. <u>0.258</u>		
Fine sand			10	25	10. Screen: Manufacturer's name <u>Western Plastics</u> Type <u>RMP</u> Dia. <u>5 1/2"</u> Slot/gauze <u>3/32</u> Length <u>60'</u> Set between <u>152</u> ft. and <u>212</u> ft. _____ ft. and _____ ft.		
Total loss of circulation			25	212	Gravel pack? <u>Yes</u> Size range of material <u>1/16 to 3/8</u>		
					11. Static water level: _____ mo./day/yr. <u>160</u> ft. below land surface Date <u>10/13/76</u>		
					12. Pumping level below land surfaces: _____ ft. after _____ hrs. pumping _____ g.p.m. _____ ft. after _____ hrs. pumping _____ g.p.m. Estimated maximum yield <u>50</u> g.p.m.		
					13. Water sample submitted: _____ mo./day/yr. <input type="checkbox"/> Yes <input checked="" type="checkbox"/> No Date _____		
					14. Well head completion: <input type="checkbox"/> Pitless adapter <u>18</u> Inches above grade		
					15. Well grouted? <u>Yes</u> With: <input checked="" type="checkbox"/> Neat cement <input type="checkbox"/> Bentonite <input type="checkbox"/> Concrete Depth: From <u>0</u> ft. to <u>10</u> ft.		
					16. Nearest source of possible contamination <u>sewer</u> ft. <u>75</u> Direction <u>west</u> Type <u>line</u> Well disinfected upon completion? <input type="checkbox"/> Yes <input type="checkbox"/> No		
					17. Pump: _____ Not installed Manufacturer's name <u>Red Jacket</u> Model number <u>500T1-17DCHP</u> <u>5</u> Volts <u>230</u> Length of drop pipe <u>110'</u> ft. capacity <u>45</u> g.p.m. Type: <input checked="" type="checkbox"/> Submersible <input type="checkbox"/> Turbine <input type="checkbox"/> Jet <input type="checkbox"/> Reciprocating <input type="checkbox"/> Centrifugal <input type="checkbox"/> Other		
(Use a second sheet if needed)					20. Water well contractor's certification: This well was drilled under my jurisdiction and this report is true to the best of my knowledge and belief. <u>Rader Drilling Co.</u> 194 Business name License No. _____ Address <u>Carlton, Kansas</u> 67429 Signed <u>Brant E Rader</u> Date <u>11-30</u> Authorized representative		
18. Elevation:		19. Remarks:					
Topography: <input type="checkbox"/> Hill <input type="checkbox"/> Slope <input type="checkbox"/> Upland <input type="checkbox"/> Valley							

Forward the white, blue and pink copies to the Department of Health and Environment

Form WWC-5

12  
 T  
 R  
 S  
 W  
 11  
 Sec  
 1/4  
 1/4  
 1/4  
 1/4