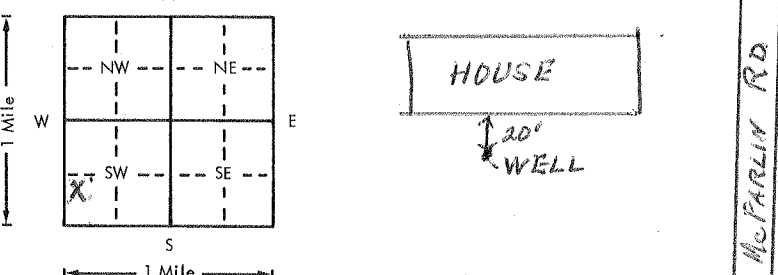


USE TYPEWRITER OR BALL POINT PEN—PRESS FIRMLY, PRINT CLEARLY.

WATER WELL RECORD
KSA 82a-1201-1215

Kansas Department of Health and Environment—Division of Environment (Water well Contractors)
Topeka, Kansas 66620

1. Location of well:		County Geary	Fraction NW 1/4 SW 1/4 SW 1/4	Section number 11	Township number T 12 S	Range number R 5 E
2. Distance and direction from nearest town or city: Street address of well location if in city: 1220 McFarlin Rd. Junction City, Kans.			3. Owner of well: Lester Matlock R.R. or street: 1220 McFarlin Rd. City, state, zip code: Junction City, Ks.			
4. Locate with "X" in section below: N W E S 1 Mile 1 Mile			Sketch map: 		6. Bore hole dia. <u>8</u> in. Completion date <u>8-20-76</u> Well depth <u>141</u> ft.	
5. Type and color of material			From	To	7. <input type="checkbox"/> Cable tool <input checked="" type="checkbox"/> Rotary <input type="checkbox"/> Driven <input type="checkbox"/> Dug <input type="checkbox"/> Hollow rod <input type="checkbox"/> Jetted <input type="checkbox"/> Bored <input type="checkbox"/> Reverse rotary	
					8. Use: <input type="checkbox"/> Domestic <input type="checkbox"/> Public supply <input type="checkbox"/> Industry <input checked="" type="checkbox"/> Irrigation <input type="checkbox"/> Air conditioning <input type="checkbox"/> Stock <input type="checkbox"/> Lawn <input type="checkbox"/> Oil field water <input type="checkbox"/> Other	
					9. Casing: Material <u>plst</u> Height: Above or below Threaded <input type="checkbox"/> Welded <input type="checkbox"/> Surface <u>18</u> in. RMP <input checked="" type="checkbox"/> PVC <input type="checkbox"/> Weight <u> </u> lbs./ft. Dia. <u>5</u> in. to <u>141</u> ft. depth; Wall Thickness: inches or Dia. <u> </u> in. to <u> </u> ft. depth; gage No. <u>0.250</u>	
					10. Screen: Manufacturer's name <u>Western Plastics</u> Type <u>RMP</u> Dia. <u>5 1/2</u> in. Slot/gauze <u>3/32</u> Length <u>60'</u> Set between <u>81</u> ft. and <u>141</u> ft. <u> </u> ft. and <u> </u> ft. Gravel pack? <u>Yes</u> Size range of material <u>1/16 to 3/8</u>	
					11. Static water level: <u>78</u> ft. below land surface Date <u>8-20-76</u> mo./day/yr.	
					12. Pumping level below land surfaces: <u> </u> ft. after <u> </u> hrs. pumping <u> </u> g.p.m. <u> </u> ft. after <u> </u> hrs. pumping <u> </u> g.p.m. Estimated maximum yield <u>12*</u> g.p.m.	
					13. Water sample submitted: <u> </u> mo./day/yr. <input type="checkbox"/> Yes <input checked="" type="checkbox"/> No Date <u> </u>	
					14. Well head completion: <input type="checkbox"/> Pitless adapter <u>18</u> Inches above grade	
					15. Well grouted? <u>Yes</u> With: <input checked="" type="checkbox"/> Neat cement <input type="checkbox"/> Bentonite <input type="checkbox"/> Concrete Depth: From <u>0</u> ft. to <u>10</u> ft.	
					16. Nearest source of possible contamination: ft. <u> </u> Direction <u> </u> Type <u> </u> Well disinfected upon completion? <input type="checkbox"/> Yes <input checked="" type="checkbox"/> No	
					17. Pump: <input type="checkbox"/> Not installed Manufacturer's name <u>Dempster</u> Model number <u> </u> HP <u>1</u> Volts <u>220</u> Length of drop pipe <u>130</u> ft. capacity <u> </u> g.p.m. Type: <input checked="" type="checkbox"/> Submersible <input type="checkbox"/> Turbine <input type="checkbox"/> Jet <input type="checkbox"/> Reciprocating <input type="checkbox"/> Centrifugal <input type="checkbox"/> Other	
18. Elevation:			19. Remarks:			
Topography: <input type="checkbox"/> Hill <input type="checkbox"/> Slope <input type="checkbox"/> Upland <input type="checkbox"/> Valley			(Use a second sheet if needed)			
			20. Water well contractor's certification: This well was drilled under my jurisdiction and this report is true to the best of my knowledge and belief. <u>Rader Drilling Co.</u> License No. <u>194</u> Business name <u> </u> License No. <u> </u> Address <u>Carlton, Kansas 67129</u> Signed <u>Brent E. Rader</u> Date <u>8-20-76</u> Authorized representative			

Forward the white, blue and pink copies to the Department of Health and Environment

Form WWC-5