


1 LOCATION OF WATER WELL: Fraction SE 1/4 NE 1/4 SW 1/4 Section Number 11 Township Number T 12 S Range Number R 5 E
 County: Geary

Distance and direction from nearest town or city street address of well if located within city?
At Junction, City 296 exit on I-70 South West 1/4 mile

2 WATER WELL OWNER: Melvin Hayes
 RR#, St. Address, Box # : 801 E. 7th Board of Agriculture, Division of Water Resources
 City, State, ZIP Code : Junction, City Kansas 66441 Application Number:

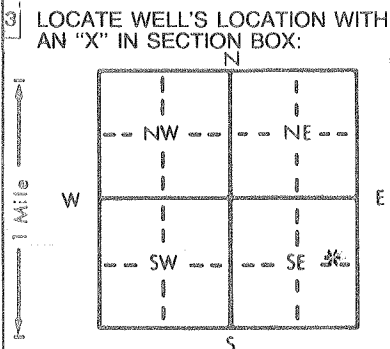

4 DEPTH OF COMPLETED WELL... 52... ft. ELEVATION: ft.
 Depth(s) Groundwater Encountered 1. 32... ft. 2. ft. 3. ft.
 WELL'S STATIC WATER LEVEL ... 26... ft. below land surface measured on mo/day/yr 8 / 2 / 88
 Pump test data: Well water was ft. after hours pumping gpm
 Est. Yield ... 15... gpm: Well water was ft. after hours pumping gpm
 Bore Hole Diameter. 9... in. to 52... ft., and in. to ft.
 WELL WATER TO BE USED AS: 5 Public water supply 8 Air conditioning 11 Injection well
 1 Domestic 3 Feedlot 6 Oil field water supply 9 Dewatering 12 Other (Specify below)
 2 Irrigation 4 Industrial 7 Lawn and garden only 10 Monitoring well
 Was a chemical/bacteriological sample submitted to Department? Yes.....No.....*.....; If yes, mo/day/yr sample was submitted Water Well Disinfected? Yes * No

5 TYPE OF CASING USED: 5 Wrought iron 8 Concrete tile CASING JOINTS: Glued * Clamped
 1 Steel 3 RMP (SR) 6 Asbestos-Cement 9 Other (specify below) Welded
 2 PVC 4 ABS 7 Fiberglass Threaded
 Blank casing diameter ... 5... in. to 52... ft., Dia in. to ft.
 Casing height above land surface ... 20... in., weight 160... lbs./ft. Wall thickness or gauge No. 214

TYPE OF SCREEN OR PERFORATION MATERIAL: 7 PVC 10 Asbestos-cement
 1 Steel 3 Stainless steel 5 Fiberglass 8 RMP (SR) 11 Other (specify)
 2 Brass 4 Galvanized steel 6 Concrete tile 9 ABS 12 None used (open hole)

SCREEN OR PERFORATION OPENINGS ARE: 5 Gauzed wrapped 8 Saw cut 11 None (open hole)
 1 Continuous slot 3 Mill slot 6 Wire wrapped 9 Drilled holes
 2 Louvered shutter 4 Key punched 7 Torch cut 10 Other (specify)

SCREEN-PERFORATED INTERVALS: From 32... ft. to 52... ft., From ft. to ft.
 From ft. to ft., From ft. to ft.
 GRAVEL PACK INTERVALS: From 23... ft. to 52... ft., From ft. to ft.
 From ft. to ft., From ft. to ft.

6 GROUT MATERIAL: 1 Neat cement 2 Cement grout 3 Bentonite 4 Other
 Grout Intervals: From ... 3... ft. to ... 23... ft., From ft. to ft., From ft. to ft.
 What is the nearest source of possible contamination: 10 Livestock pens 14 Abandoned water well
 1 Septic tank 4 Lateral lines 7 Pit privy 11 Fuel storage 15 Oil well/Gas well
 2 Sewer lines 5 Cess pool 8 Sewage lagoon 12 Fertilizer storage 16 Other (specify below)
 3 Watertight sewer lines 6 Seepage pit 9 Feedyard 13 Insecticide storage
 Direction from well? EAST How many feet? approx 1/4 mile

FROM	TO	LITHOLOGIC LOG	FROM	TO	PLUGGING INTERVALS
0	3	DARK TOP SOIL			
3	21	BROWN CLAY			
21	28	FINE SAND & CLAY			
28	52	GRAVEL & SAND			

7 CONTRACTOR'S OR LANDOWNER'S CERTIFICATION: This water well was (1) constructed, (2) reconstructed, or (3) plugged under my jurisdiction and was completed on (mo/day/year) .. 8 / 2 / 88... and this record is true to the best of my knowledge and belief. Kansas Water Well Contractor's License No. 397... This Water Well Record was completed on (mo/day/yr) 9 / 10 / 88... under the business name of CENTRAL KANSAS DRILLING by (signature) Harold D. Martin

INSTRUCTIONS: Use typewriter or ball point pen. PLEASE PRESS FIRMLY and PRINT clearly. Please fill in blanks, underline or circle the correct answers. Send top three copies to Kansas Department of Health and Environment, Bureau of Water Protection, Topeka, Kansas 66620-7320. Telephone: 913-296-5514. Send one to WATER WELL OWNER and retain one for your records.

4920000088-40