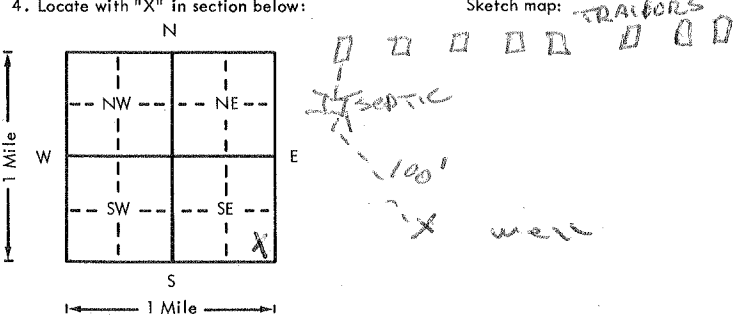


2-3-77 to Leonard
P.C.

USE TYPEWRITER OR BALL POINT PEN-PRESS FIRMLY, PRINT CLEARLY.

WATER WELL RECORD
KSA 82a-1201-1215

Kansas Department of Health and Environment-Division of Environment (Water well Contractors) Topeka, Kansas 66620

1. Location of well:	County 1 Geary	Fraction SE 1/4 SE 1/4 SE 1/4	Section number #12	Township number T 12 S	Range number R 5 E/W
2. Distance and direction from nearest town or city: Street address of well location if in city: IN JUNCTION CITY			3. Owner of well: Sherbert Dairy TRAILOR COURT R.R. or street: 202 E Vine City, state, zip code: JUNCTION CITY		
4. Locate with "X" in section below: 			6. Bore hole dia. 12 in. Completion date _____ Well depth 55 ft. 10-18-76		
5. Type and color of material			7. <input type="checkbox"/> Cable tool <input checked="" type="checkbox"/> Rotary <input type="checkbox"/> Driven <input type="checkbox"/> Dug <input type="checkbox"/> Hollow rod <input type="checkbox"/> Jetted <input type="checkbox"/> Bored <input type="checkbox"/> Reverse rotary		
			8. Use: <input type="checkbox"/> Domestic <input checked="" type="checkbox"/> Public supply <input type="checkbox"/> Industry <input type="checkbox"/> Irrigation <input type="checkbox"/> Air conditioning <input type="checkbox"/> Stock <input type="checkbox"/> Lawn <input type="checkbox"/> Oil field water <input type="checkbox"/> Other		
			9. Casing: Material PVC Height: Above or below Threaded _____ Welded _____ Surface 24 in. RMP _____ PVC 9L Weight 258 lbs./ft. Dia. 5 in. to 55 ft. depth Wall Thickness: inches or Dia. _____ in. to _____ ft. depth gage No. 2074		
			10. Screen: Manufacturer's name _____ Pumpco Type PVC Dia. 5 Slot/gauze 1060 Length 30 Set between 35 ft. and 55 ft. Gravel pack? <input checked="" type="checkbox"/> Size range of material 1/4x1/8		
			11. Static water level: _____ mo./day/yr. 20 ft. below land surface Date 10-18-76		
			12. Pumping level below land surfaces: _____ ft. after _____ hrs. pumping _____ g.p.m. _____ ft. after _____ hrs. pumping _____ g.p.m. Estimated maximum yield 200 g.p.m.		
			13. Water sample submitted: _____ mo./day/yr. <input checked="" type="checkbox"/> Yes <input type="checkbox"/> No Date 10-20-76		
			14. Well-head completion: well seal <input checked="" type="checkbox"/> Pitless adapter 24 inches above grade		
			15. Well grouted? <input checked="" type="checkbox"/> With: _____ Neat cement _____ Bentonite _____ Concrete Depth: From 0 ft. to 30 ft.		
			16. Nearest source of possible contamination: septic ft. 100 Direction N Type septic Well disinfected upon completion? <input checked="" type="checkbox"/> Yes <input type="checkbox"/> No		
			17. Pump: _____ Not installed Manufacturer's name JACOZZI Model number 134B HP 1 1/2 Volts 220 Length of drop pipe 40 ft. capacity 50 g.p.m. Type: <input checked="" type="checkbox"/> Submersible _____ Turbine <input type="checkbox"/> Jet _____ Reciprocating <input type="checkbox"/> Centrifugal _____ Other		
18. Elevation:			20. Water well contractor's certification: This well was drilled under my jurisdiction and this report is true to the best of my knowledge and belief. STRAKER DOLY CO INC 1822 Business name _____ License No. _____ Address RT 1 Holton, KS Signed Dale Peterson Date 10-18-76 Authorized representative		
19. Remarks: slab 6x6x12 - installed					

Forward the white, blue and pink copies to the Department of Health and Environment

Form WWC-5