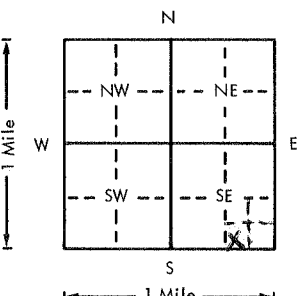
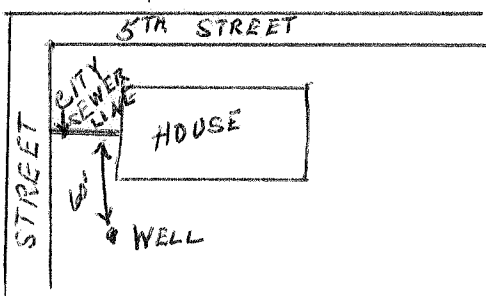


USE TYPEWRITER OR BALL POINT PEN—PRESS FIRMLY, PRINT CLEARLY.

WATER WELL RECORD  
KSA 82a-1201-1215

Kansas Department of Health and Environment—Division of Environment (Water well Contractors) Topeka, Kansas 66620

1. Location of well:		County <u>Geary</u>	Fraction <u>SW 1/4 SE 1/4 SE 1/4</u>	Section number <u>12</u>	Township number <u>T 12 S</u>	Range number <u>R 5</u> <span style="float:right;">EW</span>
2. Distance and direction from nearest town or city: Street address of well location if in city: <u>539 W. 5th Junction City, Ks</u>			3. Owner of well: <u>Ralph Heller</u> R.R. or street: <u>539 W. 5th</u> City, state, zip code: <u>Junction City, Kans.</u>			
4. Locate with "X" in section below: 			Sketch map: 		6. Bore hole dia. <u>8</u> in. Completion date _____ Well depth <u>74</u> ft. <u>6-30-76</u>	
5. Type and color of material			From		To	
			Clay		0	12
		Sand		12	16	
		Sandy clay		16	38	
		Clay mixed sand		38	63	
		Fine sand		63	71	
		Coarse sand		71	74	
					7. <input type="checkbox"/> Cable tool <input checked="" type="checkbox"/> Rotary <input type="checkbox"/> Driven <input type="checkbox"/> Dug <input type="checkbox"/> Hollow rod <input type="checkbox"/> Jetted <input type="checkbox"/> Bored <input type="checkbox"/> Reverse rotary	
					8. Use: <input type="checkbox"/> Domestic <input type="checkbox"/> Public supply <input type="checkbox"/> Industry <input checked="" type="checkbox"/> Irrigation <input type="checkbox"/> Air conditioning <input type="checkbox"/> Stock <input type="checkbox"/> Lawn <input type="checkbox"/> Oil field water <input type="checkbox"/> Other	
					9. Casing: Material <u>plst</u> Height: Above or below Threaded <input type="checkbox"/> Welded <u>gl</u> Surface _____ in. RMP <input checked="" type="checkbox"/> PVC _____ Weight _____ lbs./ft. Dia. <u>5</u> in. to <u>74</u> ft. depth Wall Thickness: inches or Dia. _____ in. to _____ ft. depth gage No. _____	
					10. Screen: Manufacturer's name <u>Western Plastics</u> Type <u>RMP</u> Dia. <u>5 1/2</u> Slot/gauze <u>3/32</u> Length <u>2 1/2</u> Set between <u>71 1/2</u> ft. and <u>74</u> ft. _____ ft. and _____ ft. Gravel pack? <u>Yes</u> Size range of material <u>1/16 to 3/8</u>	
					11. Static water level: _____ mo./day/yr. <u>50</u> ft. below land surface Date <u>6/30/76</u>	
					12. Pumping level below land surfaces: _____ ft. after _____ hrs. pumping _____ g.p.m. _____ ft. after _____ hrs. pumping _____ g.p.m. Estimated maximum yield <u>16 1/2</u> g.p.m.	
					13. Water sample submitted: _____ mo./day/yr. Yes <input type="checkbox"/> No <input checked="" type="checkbox"/> Date _____	
					14. Well head completion: <input type="checkbox"/> Pitless adapter <u>18</u> inches above grade	
					15. Well grouted? <u>Yes</u> With: <input checked="" type="checkbox"/> Neat cement <input type="checkbox"/> Bentonite <input type="checkbox"/> Concrete Depth: From <u>0</u> ft. to <u>10</u> ft.	
					16. Nearest source of possible contamination: ft. _____ Direction _____ Type _____ Well disinfected upon completion? _____ Yes <input checked="" type="checkbox"/> No	
					17. Pump: _____ Not installed Manufacturer's name <u>Dempster</u> Model number _____ HP <u>3/4</u> Volts <u>220</u> Length of drop pipe <u>70</u> ft. capacity _____ g.p.m. Type: <input checked="" type="checkbox"/> Submersible _____ Turbine <input type="checkbox"/> Jet _____ Reciprocating <input type="checkbox"/> Centrifugal _____ Other	
					20. Water well contractor's certification: This well was drilled under my jurisdiction and this report is true to the best of my knowledge and belief. <u>Rader Drilling Co.</u> <u>194</u> Business name License No. Address <u>Carlton, Kans. 67429</u> Signed <u>Bruce E. Rader</u> Date <u>8-24</u> Authorized representative	
18. Elevation:		19. Remarks:				
Topography: <input type="checkbox"/> Hill <input type="checkbox"/> Slope <input type="checkbox"/> Upland <input checked="" type="checkbox"/> Valley						

Forward the white, blue and pink copies to the Department of Health and Environment

Form WWC-5