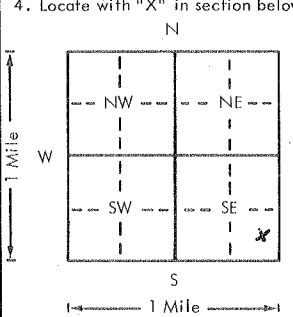


USE TYPEWRITER OR BALL POINT PEN-PRESS FIRMLY, PRINT CLEARLY.

WATER WELL RECORD
KSA 82a-1201-1215

Kansas Department of Health and Environment-Division of Environment (Water well Contractors) Topeka, Kansas 66620

1. Location of well:	County: <u>Searcy</u>	Fraction: <u>SE 1/4 SE 1/4 SE 1/4</u>	Section number: <u>13</u>	Township number: <u>T 12 S</u>	Range number: <u>R 5 E/W</u>																														
2. Distance and direction from nearest town or city: <u>10 miles SW of Junction city.</u>			3. Owner of well: <u>Dennis Lilly</u> R.R. or street: <u>R. 1 Box 26</u> City, state, zip code: <u>Junction City, Ko, 66441</u>																																
4. Locate with "X" in section below: 				6. Bore hole dia. <u>8</u> in. Completion date: <u>5-24-79</u> Well depth: <u>82</u> ft.																															
5. Type and color of material				7. <input checked="" type="checkbox"/> Cable tool <input checked="" type="checkbox"/> Rotary <input type="checkbox"/> Driven <input type="checkbox"/> Dug <input type="checkbox"/> Hollow rod <input type="checkbox"/> Jetted <input type="checkbox"/> Bored <input type="checkbox"/> Reverse rotary																															
				8. Use: <input checked="" type="checkbox"/> Domestic <input type="checkbox"/> Public supply <input type="checkbox"/> Industry <input type="checkbox"/> Irrigation <input type="checkbox"/> Air conditioning <input type="checkbox"/> Stock <input type="checkbox"/> Lawn <input type="checkbox"/> Oil field water <input type="checkbox"/> Other																															
<table border="1" style="width:100%; border-collapse: collapse;"> <thead> <tr> <th style="width:80%;"></th> <th style="width:10%;">From</th> <th style="width:10%;">To</th> </tr> </thead> <tbody> <tr><td><u>soil top</u></td><td><u>0</u></td><td><u>2</u></td></tr> <tr><td><u>clay Brown</u></td><td><u>2</u></td><td><u>14</u></td></tr> <tr><td><u>Limestone soft</u></td><td><u>14</u></td><td><u>29</u></td></tr> <tr><td><u>shale Gray</u></td><td><u>29</u></td><td><u>39</u></td></tr> <tr><td><u>limestone Gray water</u></td><td><u>39</u></td><td><u>45</u></td></tr> <tr><td><u>shale Gray</u></td><td><u>45</u></td><td><u>51</u></td></tr> <tr><td><u>limestone Gray</u></td><td><u>51</u></td><td><u>53</u></td></tr> <tr><td><u>shale Gray</u></td><td><u>53</u></td><td><u>55</u></td></tr> <tr><td><u>limestone + flint</u></td><td><u>55</u></td><td><u>82</u></td></tr>Casing: Material <u>PVC</u> Height: Above or below Threaded <input type="checkbox"/> Welded <input type="checkbox"/> Surface <u>12</u> in. RMP <input type="checkbox"/> PVC <input type="checkbox"/> Weight <u>200</u> lbs./ft. Dia. <u>5</u> in. to <u>82</u> ft. depth <input checked="" type="checkbox"/> All Thickness: inches or Dia. <u> </u> in. to <u> </u> ft. depth gage No. <u>200</u>	
(Use a second sheet if needed)				10. Screen: Manufacturer's name <u>plastic NSF approved</u> Type <u>plastic</u> Dia. <u>3 in</u> Slot/gauze <u>.060</u> Length <u>40</u> Set between <u>35</u> ft. and <u>75</u> ft. <u> </u> ft. and <u> </u> ft. Gravel pack? <u>yes</u> Size range of material <u>1/4 to 1/2</u>																															
				11. Static water level: <u>37</u> ft. below land surface Date <u>5-24-79</u> mo./day/yr.																															
18. Elevation: Topography: <input type="checkbox"/> Hill <input type="checkbox"/> Slope <input type="checkbox"/> Upland <input type="checkbox"/> Valley				12. Pumping level below land surfaces: <u> </u> ft. after <u> </u> hrs. pumping <u> </u> g.p.m. <u> </u> ft. after <u> </u> hrs. pumping <u> </u> g.p.m. Estimated maximum yield <u> </u> g.p.m.																															
				13. Water sample submitted: <u> </u> mo./day/yr. Yes <input checked="" type="checkbox"/> No <input type="checkbox"/> Date <u> </u>																															
19. Remarks:				14. Well head completion: <u>Capped</u> <input type="checkbox"/> Pitless adapter <u> </u> inches above grade																															
				15. Well grouted? <u>yes</u> With: <u> </u> Neat cement <u> </u> Bentonite <input checked="" type="checkbox"/> Concrete Depth: From <u>0</u> ft. to <u>20</u> ft.																															
20. Water well contractor's certification: This well was drilled under my jurisdiction and this report is true to the best of my knowledge and belief. <u>Blue Valley Drilling 234D</u> Business name License No. <u> </u> Address <u>Blue Rapids, Ko, 66411</u> Signed <u>Gerald J. Trader</u> Date <u>5-26-79</u> Authorized representative				16. Nearest source of possible contamination: <u>road</u> ft. <u> </u> Direction <u> </u> Type <u> </u> Well disinfected upon completion? <input checked="" type="checkbox"/> Yes <input type="checkbox"/> No																															
				17. Pump: <input checked="" type="checkbox"/> Not installed Manufacturer's name <u> </u> Model number <u> </u> HP <u> </u> Volts <u> </u> Length of drop pipe <u> </u> ft. capacity <u> </u> g.p.m. Type: <input type="checkbox"/> Submersible <input type="checkbox"/> Turbine <input type="checkbox"/> Jet <input type="checkbox"/> Reciprocating <input type="checkbox"/> Centrifugal <input type="checkbox"/> Other																															

Forward the white, blue and pink copies to the Department of Health and Environment

Form WWC-5