


1 LOCATION OF WATER WELL: Fraction $\frac{1}{4}$ $\frac{1}{4}$ NW $\frac{1}{4}$ Section Number 13 Township Number T 12 S Range Number R 5 E/W
 County: Geary

Distance and direction from nearest town or city street address of well if located within city?

901 S Washington, Junction City, Ks.

2 WATER WELL OWNER: Robo Car Wash
 RR#, St. Address, Box # : 901 S Washington Board of Agriculture, Division of Water Resources
 City, State, ZIP Code : Junction City, Ks. Application Number:

3 LOCATE WELL'S LOCATION WITH AN "X" IN SECTION BOX:

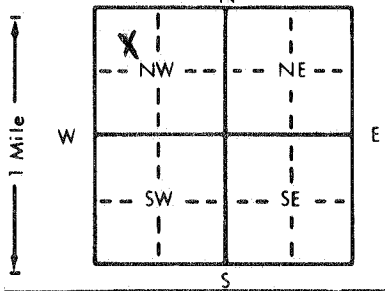

4 DEPTH OF COMPLETED WELL: 36 ft. ELEVATION:
 Depth(s) Groundwater Encountered 1. 30 ft. 2. ft. 3. ft.
 WELL'S STATIC WATER LEVEL . . . 30 . . . ft. below land surface measured on mo/day/yr . . . 7-1-91 . . .
 Pump test data: Well water was . . . ft. after . . . hours pumping . . . gpm
 Est. Yield . . . gpm: Well water was . . . ft. after . . . hours pumping . . . gpm
 Bore Hole Diameter . . . 7.5/8 . . . in. to . . . 36 . . . ft., and . . . in. to . . . ft.
 WELL WATER TO BE USED AS: 5 Public water supply 8 Air conditioning 11 Injection well
 1 Domestic 3 Feedlot 6 Oil field water supply 9 Dewatering 12 Other (Specify below)
 2 Irrigation 4 Industrial 7 Lawn and garden only 10 Monitoring well
 Was a chemical/bacteriological sample submitted to Department? Yes. . . . No. X; If yes, mo/day/yr sample was submitted
 Water Well Disinfected? Yes No X

5 TYPE OF BLANK CASING USED:
 1 Steel 3 RMP (SR) 5 Wrought iron 8 Concrete tile CASING JOINTS: Glued Clamped
2 PVC 4 ABS 6 Asbestos-Cement 9 Other (specify below) Welded
 7 Fiberglass Threaded. . . . X
 Blank casing diameter . . . 2 . . . in. to . . . 26 . . . ft., Dia . . . in. to . . . ft., Dia . . . in. to . . . ft.
 Casing height above land surface. . . 0 . . . in., weight . . . lbs./ft. Wall thickness or gauge No. . . Sch. 40

TYPE OF SCREEN OR PERFORATION MATERIAL:
 1 Steel 3 Stainless steel 5 Fiberglass 7 PVC 10 Asbestos-cement
 2 Brass 4 Galvanized steel 6 Concrete tile 8 RMP (SR) 11 Other (specify)
 12 None used (open hole)

SCREEN OR PERFORATION OPENINGS ARE:
 1 Continuous slot 3 Mill slot 5 Gauzed wrapped 8 Saw cut 11 None (open hole)
 2 Louvered shutter 4 Key punched 6 Wire wrapped 9 Drilled holes
 7 Torch cut 10 Other (specify)

SCREEN-PERFORATED INTERVALS: From . . . 36 . . . ft. to . . . 26 . . . ft., From . . . ft. to . . . ft.
 From . . . ft. to . . . ft., From . . . ft. to . . . ft.
 GRAVEL PACK INTERVALS: From . . . 36 . . . ft. to . . . 24 . . . ft., From . . . ft. to . . . ft.
 From . . . ft. to . . . ft., From . . . ft. to . . . ft.

6 GROUT MATERIAL: 1 Neat cement 2 Cement grout 3 Bentonite 4 Other
 Grout Intervals: From . . . 24 . . . ft. to . . . 3 . . . (bent) . . . ft., From . . . 3 . . . ft. to 0 . . . (cement) . . . ft., From . . . ft. to . . . ft.
 What is the nearest source of possible contamination:
 1 Septic tank 4 Lateral lines 7 Pit privy 10 Livestock pens 14 Abandoned water well
 2 Sewer lines 5 Cess pool 8 Sewage lagoon 11 Fuel storage 15 Oil well/Gas well
 3 Watertight sewer lines 6 Seepage pit 9 Feedyard 12 Fertilizer storage 16 Other (specify below)
 13 Insecticide storage Abandoned fuel storage
 Direction from well? West How many feet? 10

FROM	TO	LITHOLOGIC LOG	FROM	TO	PLUGGING INTERVALS
0	.5	Concrete			
.5	6	Clay-silty, black			
6	9	Clay-silty, grayish brown			
9	14	Silt-sandy, gray			
14	18	Silt - sandy, grayish brown			
18	22	Sand-Medium, silty, brownish gray			
22	31	Silt-sandy, gray			
31	36	Sand-gravel-medium to coarse, silty, grayish green			

7 CONTRACTOR'S OR LANDOWNER'S CERTIFICATION: This water well was (1) constructed (2) reconstructed, or (3) plugged under my jurisdiction and was completed on (mo/day/year) 6-14-91 and this record is true to the best of my knowledge and belief. Kansas Water Well Contractor's License No. . . . 527 This Water Well Record was completed on (mo/day/yr) 7-10-91 under the business name of GeoCore Services, Inc. by (signature) Dale G. Pull

INSTRUCTIONS: Use typewriter or ball point pen. PLEASE PRESS FIRMLY and PRINT clearly. Please fill in blanks, underline or circle the correct answers. Send top three copies to Kansas Department of Health and Environment, Bureau of Water, Topeka, Kansas 66620-7320. Telephone: 913-296-5545. Send one to WATER WELL OWNER and retain one for your records.