


1] LOCATION OF WATER WELL: Fraction  $\frac{1}{4}$   $\frac{1}{4}$  NW  $\frac{1}{4}$  Section Number 13 Township Number T 12 S Range Number R 5 **E/W**

Distance and direction from nearest town or city street address of well if located within city?

901 S Washington, Junction City, Ks.

2] WATER WELL OWNER: Robo Car Wash  
 RR#, St. Address, Box # : 901 S Washington Board of Agriculture, Division of Water Resources  
 City, State, ZIP Code : Junction City, Ks. Application Number:

3] LOCATE WELL'S LOCATION WITH AN "X" IN SECTION BOX: 4] DEPTH OF COMPLETED WELL... 31... ft. ELEVATION: ...

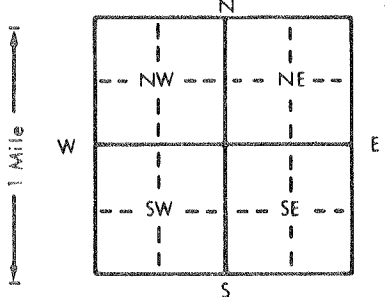

Depth(s) Groundwater Encountered 1... 27... ft. 2... ft. 3... ft.  
 WELL'S STATIC WATER LEVEL... 27... ft. below land surface measured on mo/day/yr... 7-1-91...  
 Pump test data: Well water was... ft. after... hours pumping... gpm  
 Est. Yield... gpm: Well water was... ft. after... hours pumping... gpm  
 Bore Hole Diameter... 7.5/8... in. to... 33... ft., and... in. to... ft.  
 WELL WATER TO BE USED AS: 5 Public water supply 8 Air conditioning 11 Injection well  
 1 Domestic 3 Feedlot 6 Oil field water supply 9 Dewatering 12 Other (Specify below)  
 2 Irrigation 4 Industrial 7 Lawn and garden only **10 Monitoring well**  
 Was a chemical/bacteriological sample submitted to Department? Yes... No... **X**...; If yes, mo/day/yr sample was submitted  
 Water Well Disinfected? Yes No **X**

5] TYPE OF BLANK CASING USED: 5 Wrought iron 8 Concrete tile CASING JOINTS: Glued... Clamped...  
 1 Steel 3 RMP (SR) 6 Asbestos-Cement 9 Other (specify below) Welded...  
**2 PVC** 4 ABS 7 Fiberglass Threaded... **X**

Blank casing diameter... 2... in. to... 21... ft., Dia... in. to... ft., Dia... in. to... ft.  
 Casing height above land surface... 24... in., weight... lbs./ft. Wall thickness or gauge No. Sch. 40

TYPE OF SCREEN OR PERFORATION MATERIAL: **7 PVC** 10 Asbestos-cement  
 1 Steel 3 Stainless steel 5 Fiberglass 8 RMP (SR) 11 Other (specify)  
 2 Brass 4 Galvanized steel 6 Concrete tile 9 ABS 12 None used (open hole)

SCREEN OR PERFORATION OPENINGS ARE: 5 Gauzed wrapped 8 Saw cut 11 None (open hole)  
 1 Continuous slot **3 Mill slot** 6 Wire wrapped 9 Drilled holes  
 2 Louvered shutter 4 Key punched 7 Torch cut 10 Other (specify)

SCREEN-PERFORATED INTERVALS: From... 31... ft. to... 21... ft., From... ft. to... ft.  
 From... ft. to... ft., From... ft. to... ft.

GRAVEL PACK INTERVALS: From... 31... ft. to... 19... ft., From... ft. to... ft.  
 From... ft. to... ft., From... ft. to... ft.

6] GROUT MATERIAL: 1 Neat cement **2 Cement grout** **3 Bentonite** 4 Other  
 Grout Intervals: From... 19... ft. to **16(bent)**... ft., From... 16... ft. to... 0 (cement) ft., From... ft. to... ft.

What is the nearest source of possible contamination:  
 1 Septic tank 4 Lateral lines 7 Pit privy 10 Livestock pens 14 Abandoned water well  
 2 Sewer lines 5 Cess pool 8 Sewage lagoon 11 Fuel storage 15 Oil well/Gas well  
 3 Watertight sewer lines 6 Seepage pit 9 Feedyard 12 Fertilizer storage **16 Other (specify below)**  
 Abandoned fuel storage

Direction from well? NW How many feet? 75

FROM	TO	LITHOLOGIC LOG	FROM	TO	PLUGGING INTERVALS
0	2	Gravel, fill			
2	3	Topsoil black			
3	8	Clay- sandy, silty, dark brown			
8	14	Silt- sandy very fine brown			
14	21	Silt- sandy, fine, brown			
21	24	Sand-medium, silty, reddish brown			Completed at the surface with an
24	29	Silt- sandy, very fine, grayish brown			above ground, locking, steel protective
29	33	Sand-medium, silty, brown			cover.

7] CONTRACTOR'S OR LANDOWNER'S CERTIFICATION: This water well was **(1) constructed**, (2) reconstructed, or (3) plugged under my jurisdiction and was completed on (mo/day/year) ... 7-1-91 ... and this record is true to the best of my knowledge and belief. Kansas Water Well Contractor's License No. ... 527 ... This Water Well Record was completed on (mo/day/yr) ... 7-10-91 ... under the business name of **GeoCore Services, Inc.** by (signature) *Dale A Bell*