


LOCATION OF WATER WELL: County: **GEARY** Fraction: **SE 1/4 SE 1/4 NE 1/4** Section Number: **14** Township Number: **T 12 S** Range Number: **R 5 E/W**

Distance and direction from nearest town or city street address of well if located within city?
1128 S WASHINGTON OW-6

WATER WELL OWNER: **AMCO**
 RR#, St. Address, Box #: **1128 S WASHINGTON** Board of Agriculture, Division of Water Resources
 City, State, ZIP Code: **JC KS** Application Number:

LOCATE WELL'S LOCATION WITH AN "X" IN SECTION BOX: DEPTH OF COMPLETED WELL: **34** ft. ELEVATION:

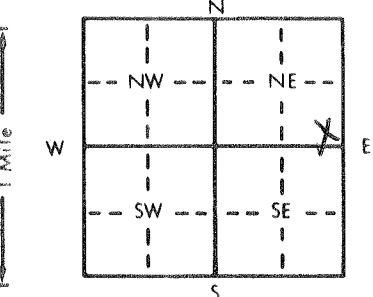

Depth(s) Groundwater Encountered: **1** ft. 2. ft. 3. ft.
 WELL'S STATIC WATER LEVEL: **31** ft. below land surface measured on mo/day/yr: **10/26/90**
 Pump test data: Well water was _____ ft. after _____ hours pumping _____ gpm
 Est. Yield _____ gpm Well water was _____ ft. after _____ hours pumping _____ gpm
 Bore Hole Diameter: **8** in. to **34** ft. and _____ in. to _____ ft.
 WELL WATER TO BE USED AS:
 1 Domestic 3 Feedlot 6 Oil field water supply 9 Dewatering 12 Other (Specify below)
 2 Irrigation 4 Industrial 7 Lawn and garden only **10 Observation well**
 Was a chemical/bacteriological sample submitted to Department? Yes _____ No _____ If yes, mo/day/yr sample was submitted _____
 Water Well Disinfected? Yes _____ No _____

TYPE OF BLANK CASING USED:
 1 Steel 3 RMP (SR) 5 Wrought iron 8 Concrete tile CASING JOINTS: Glued _____ Clamped _____
2 PVC 4 ABS 6 Asbestos-Cement 9 Other (specify below) Welded _____
 7 Fiberglass _____ Threaded _____
 Blank casing diameter: **2** in. to **24** ft. Dia _____ in. to _____ ft. Dia _____ in. to _____ ft.
 Casing height above land surface _____ in., weight _____ lbs./ft. Wall thickness or gauge No. _____

TYPE OF SCREEN OR PERFORATION MATERIAL:
 1 Steel 3 Stainless steel 5 Fiberglass **7 PVC** 10 Asbestos-cement
 2 Brass 4 Galvanized steel 6 Concrete tile 8 RMP (SR) 11 Other (specify) _____
 12 None used (open hole)

SCREEN OR PERFORATION OPENINGS ARE:
 1 Continuous slot **3 Mill slot** 5 Gauzed wrapped 8 Saw cut 11 None (open hole)
 2 Louvered shutter 4 Key punched 6 Wire wrapped 9 Drilled holes
 7 Torch cut 10 Other (specify) _____

SCREEN-PERFORATED INTERVALS: From **24** ft. to **34** ft. From _____ ft. to _____ ft.
 GRAVEL PACK INTERVALS: From **22** ft. to **34** ft. From _____ ft. to _____ ft.

GROUT MATERIAL: 1 Neat cement 2 Cement grout **3 Bentonite** 4 Other _____
 Grout Intervals: From **0** ft. to **22** ft. From _____ ft. to _____ ft.

What is the nearest source of possible contamination:
 1 Septic tank 4 Lateral lines 7 Pit privy **11 Fuel storage** 14 Abandoned water well
 2 Sewer lines 5 Cess pool 8 Sewage lagoon 12 Fertilizer storage 15 Oil well/Gas well
 3 Watertight sewer lines 6 Seepage pit 9 Feedyard 13 Insecticide storage 16 Other (specify below) _____

Direction from well? **UNKNOWN** How many feet? **UNKNOWN**

FROM	TO	LITHOLOGIC LOG	FROM	TO	LITHOLOGIC LOG
0	8	Clay till			
8	21	Sand & clay			
21	34	Silty sandy clay			

approved by D. Plummer for late submittal
 4/10/91

CONTRACTOR'S OR LANDOWNER'S CERTIFICATION: This water well was **(1)** constructed, (2) reconstructed, or (3) plugged under my jurisdiction and was completed on (mo/day/year) **10/26/90** and this record is true to the best of my knowledge and belief. Kansas Water Well Contractor's License No. **102** This Water Well Record was completed on (mo/day/yr) **11/1/90** under the business name of **Gayle Weldon** by (signature) **D. Plummer**

INSTRUCTIONS: Use typewriter or ball point pen. PLEASE PRESS FIRMLY and PRINT clearly. Please fill in blanks, underline or circle the correct answers. Send top three copies to Kansas Department of Health and Environment, Division of Environment, Environmental Geology Section, Topeka, KS 66620. Send one to WATER WELL OWNER and retain one for your records.