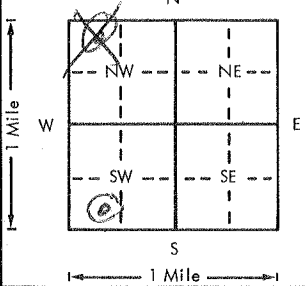


USE TYPEWRITER OR BALL POINT PEN-PRESS FIRMLY, PRINT CLEARLY.

WATER WELL RECORD
KSA 82a-1201-1215

Kansas Department of Health and Environment-Division of Environment (Water well Contractors) Topeka, Kansas 66620

1. Location of well:		County GEARY	Fraction SW 1/4 1/4 1/4	Section number 15	Township number T 12 S	Range number R 5 E								
2. Distance and direction from nearest town or city: 1 M. S of Highway 18		3. Owner of well: Robert Thunburg		4. R.R. or street: 101 SW 8th										
5. Type and color of material		6. Bore hole dia. 10 in. Completion date 4-6-76		7. Well depth 73 ft.										
4. Locate with "X" in section below: 		Sketch map:		8. Use: <input checked="" type="checkbox"/> Domestic <input type="checkbox"/> Public supply <input type="checkbox"/> Industry <input type="checkbox"/> Irrigation <input type="checkbox"/> Air conditioning <input type="checkbox"/> Stock <input type="checkbox"/> Lawn <input type="checkbox"/> Oil field water <input type="checkbox"/> Other										
<table border="1"> <thead> <tr> <th>From</th> <th>To</th> </tr> </thead> <tbody> <tr> <td>0</td> <td>40</td> </tr> <tr> <td>40</td> <td>63</td> </tr> <tr> <td>63</td> <td>73</td> </tr> </tbody> </table>		From	To	0	40	40	63	63	73	9. Casing: Material Steel Height: Above or below		10. Screen: Manufacturer's name Pumpco		
From	To													
0	40													
40	63													
63	73													
		Threading: <input checked="" type="checkbox"/> Welded <input type="checkbox"/> Surface 1 1/2 in.		Type PVC Dia. 5										
		RMP <input type="checkbox"/> PVC <input type="checkbox"/> Weight _____ lbs./ft.		Slot/gauze 5/16 Length 20										
		Dia. 6 in. to 6 3/8 ft. depth		Set between 53 ft. and 73 ft.										
		Dia. _____ in. to _____ ft. depth		Gravel pack? _____ Size range of material _____										
		11. Static water level: _____ ft. below land surface Date 4-6-76		12. Pumping level below land surfaces:										
		_____ ft. after _____ hrs. pumping _____ g.p.m.		_____ ft. after _____ hrs. pumping _____ g.p.m.										
		Estimated maximum yield _____ g.p.m.		13. Water sample submitted: _____ mo./day/yr.										
		Yes <input type="checkbox"/> No <input checked="" type="checkbox"/> Date _____		14. Well head completion: NA										
		_____ Pitless adapter _____ inches above grade		15. Well grouted? <input checked="" type="checkbox"/>										
		With: _____ Neat cement _____ Bentonite W Concrete _____		Depth: From 5 ft. to 16 ft.										
		16. Nearest source of possible contamination: _____ ft. 500 Direction EAST Type creek		Well disinfected upon completion? <input checked="" type="checkbox"/> Yes _____ No										
		17. Pump: <input checked="" type="checkbox"/> Not installed		Manufacturer's name _____										
		Model number _____ HP _____ Volts _____		Length of drop pipe _____ ft. capacity _____ g.p.m.										
		Type: _____ Submersible _____ Turbine _____ Jet _____ Reciprocating _____ Centrifugal _____ Other _____												
18. Elevation:		19. Remarks:		20. Water well contractor's certification:										
Topography: <input checked="" type="checkbox"/> Hill <input type="checkbox"/> Slope <input type="checkbox"/> Upland <input type="checkbox"/> Valley				This well was drilled under my jurisdiction and this report is true to the best of my knowledge and belief. Strader Drilling Co 237 Business name Blue Rapids License No. _____ Address _____ Signed Harold Strader Date 4-6-76 Authorized representative										

Forward the white, blue and pink copies to the Department of Health and Environment

Form WWC-5