


1 LOCATION OF WATER WELL: Fraction NW 1/4 NW 1/4 SW 1/4 Section Number 15 Township Number T 12 S Range Number R 5 **EW**
 County: Geary Distance and direction from nearest town or city street address of well if located within city?

West of Junction City, Ks at 77 Hwy 40 go West on 40 Hwy 3/4 mile & 1/2 mile North

2 WATER WELL OWNER: Steve Krojkoski
 RR#, St. Address, Box #: 522 Sheridan Dr Board of Agriculture, Division of Water Resources
 City, State, ZIP Code: Junction City, Kansas 66441 Application Number:

3 LOCATE WELL'S LOCATION WITH AN "X" IN SECTION BOX:

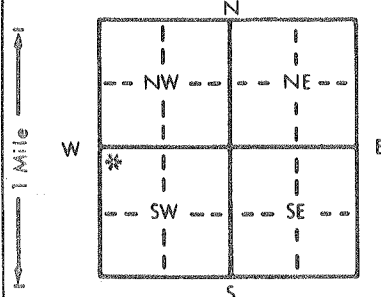

4 DEPTH OF COMPLETED WELL: 210 ft. ELEVATION:
 Depth(s) Groundwater Encountered 1. 75 ft. 2. ft. 3. ft.
 WELL'S STATIC WATER LEVEL: 72 ft. below land surface measured on mo/day/yr: 1. 6 / 89

Pump test data: Well water was ft. after hours pumping gpm
 Est. Yield 1/2 gpm: Well water was ft. after hours pumping gpm
 Bore Hole Diameter: 12 1/2 in. to 15 1/2 ft., and 8 in. to 212 ft.
 WELL WATER TO BE USED AS: 5 Public water supply 8 Air conditioning 11 Injection well
 1 Domestic 3 Feedlot 6 Oil field water supply 9 Dewatering 12 Other (Specify below)
 2 Irrigation 4 Industrial 7 Lawn and garden only 10 Monitoring well
 Was a chemical/bacteriological sample submitted to Department? Yes No *; If yes, mo/day/yr sample was submitted Water Well Disinfected? Yes * No

5 TYPE OF BLANK CASING USED: 5 Wrought iron 8 Concrete tile CASING JOINTS: Glued * Clamped
 1 Steel 3 RMP (SR) 6 Asbestos-Cement 9 Other (specify below) Welded
 2 PVC 4 ABS 7 Fiberglass Threaded

Blank casing diameter: 8 in. to 15 1/2 ft., Dia. in. to ft., Dia. in. to ft.
 Casing height above land surface: 14 in., weight 160 lbs./ft. Wall thickness or gauge No. 1/2

TYPE OF SCREEN OR PERFORATION MATERIAL: 7 PVC 10 Asbestos-cement
 1 Steel 3 Stainless steel 5 Fiberglass 8 RMP (SR) 11 Other (specify)
 2 Brass 4 Galvanized steel 6 Concrete tile 9 ABS 12 None used (open hole)

SCREEN OR PERFORATION OPENINGS ARE: 5 Gauzed wrapped 8 Saw cut 11 None (open hole)
 1 Continuous slot 3 Mill slot 6 Wire wrapped 9 Drilled holes
 2 Louvered shutter 4 Key punched 7 Torch cut 10 Other (specify)

SCREEN-PERFORATED INTERVALS: From NONE ft. to ft., From ft. to ft.
 GRAVEL PACK INTERVALS: From NONE ft. to ft., From ft. to ft.

6 GROUT MATERIAL: 1 Neat cement 2 Cement grout 3 Bentonite 4 Other
 Grout Intervals: From 3 ft. to 15 1/2 ft., From ft. to ft., From ft. to ft.

What is the nearest source of possible contamination:
 1 Septic tank 4 Lateral lines 7 Pit privy 10 Livestock pens 14 Abandoned water well
 2 Sewer lines 5 Cess pool 8 Sewage lagoon 11 Fuel storage 15 Oil well/Gas well
 3 Watertight sewer lines 6 Seepage pit 9 Feedyard 12 Fertilizer storage 16 Other (specify below)
 13 Insecticide storage

Direction from well? WEST WILL BEE APPROX How many feet? 90

FROM	TO	LITHOLOGIC LOG	FROM	TO	PLUGGING INTERVALS
0	5	BROWN CLAY	78	79	SOFT SHALE
5	11	BROWN SANDY CLAY	79	86	LITE COLOR LIMESTONE & FLINT
11	13	BROWN CLAY	86	93	DARK HARD LIMESTONE & FLINT
13	14	GRAY SHALE	93	101	GRAY CLAY & SHALE
14	15	LIMESTONE	101	107	RED SHALE
15	17	LITE COLOR SHALE	107	112	DARK LIMESTONE
17	20	LIMESTONE & FLINT	112	124	GRAY SHALE
20	24	LITE COLOR SHALE	124	125	DARK LIMESTONE
24	37	LITE COLOR LIMESTONE	125	130	GRAY SHALE & GYPSUM
37	39	DARK LIMESTONE	130	145	GRAY SHALE
39	44	GRAY SHALE	145	150	GRAY LIMESTONE & SHALE
44	54	LITE COLOR LIMESTONE	150	151	SOFT GRAY CLAY
54	62	GRAY CLAY & SHALE	151	159	LITE GRAY COLOR LIMESTONE & FLINT
62	71	FLINT & SARK LIMESTONE	159	179	DARK GRAY SHALE
71	78	LITE COLOR LIMESTONE	179	190	FLINT & LITE COLOR LIMESTONE

7 CONTRACTOR'S OR LANDOWNER'S CERTIFICATION: This water well was (1) constructed, (2) reconstructed, or (3) plugged under my jurisdiction and was completed on (mo/day/year) 4 / 6 / 89 and this record is true to the best of my knowledge and belief. Kansas Water Well Contractor's License No. 397 This Water Well Record was completed on (mo/day/yr) 5 / 17 / 89 under the business name of CENTRAL KANSAS DRILLING by (signature) Harold D. Martin

6900000088-82

Steve Krojkoski Lithologic Log
CONTINUED

190	193	GRAY CLAY
193	195	DARK LIMESTONE
195	198	GRAY SHALE
198	203	MARBON SHALE
203	205	LITE COLOR SHALE
205	208	LIMESTONE
208	210	GYPSUM