


1 LOCATION OF WATER WELL: County: Geary Fraction: Center 1/4 NE 1/4 NE 1/4 Section Number: 16 Township Number: T 12 S Range Number: R 5 E

Distance and direction from nearest town or city street address of well if located within city? From Junction City 60 West 1/2 mile on 18 Highway to Spring Valley Rd + 60 South 1/4 mile to Liberty Hill Rd + 60 West 1/4 mile

2 WATER WELL OWNER: Darrel E. Barris
 RR#, St. Address, Box #: 2521 Liberty Hill Rd. Board of Agriculture, Division of Water Resources
 City, State, ZIP Code: Junction City, Kansas 66441 Application Number:

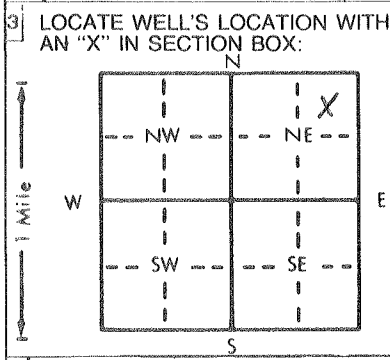

4 DEPTH OF COMPLETED WELL: 120 ft. ELEVATION:
 Depth(s) Groundwater Encountered 1. 72 ft. 2. ft. 3. ft.
 WELL'S STATIC WATER LEVEL: 70 ft. below land surface measured on mo/day/yr
 Pump test data: Well water was ft. after hours pumping gpm
 Est. Yield: 15 gpm: Well water was ft. after hours pumping gpm
 Bore Hole Diameter: 9 in. to 120 ft., and in. to ft.
 WELL WATER TO BE USED AS:
 1 Domestic 3 Feedlot 6 Oil field water supply 9 Dewatering 12 Other (Specify below)
 2 Irrigation 4 Industrial 7 Lawn and garden only 10 Monitoring well
 Was a chemical/bacteriological sample submitted to Department? Yes.....No.....; If yes, mo/day/yr sample was submitted
 Water Well Disinfected? Yes No

5 TYPE OF BLANK CASING USED:
 1 Steel 3 RMP (SR) 6 Asbestos-Cement 9 Other (specify below)
 2 PVC 4 ABS 7 Fiberglass
 Blank casing diameter: 5 in. to 100 ft., Dia in. to ft., Dia in. to ft.
 Casing height above land surface: 2 in., weight 564.40 lbs./ft. Wall thickness or gauge No.
 TYPE OF SCREEN OR PERFORATION MATERIAL:
 1 Steel 3 Stainless steel 5 Fiberglass 7 PVC 10 Asbestos-cement
 2 Brass 4 Galvanized steel 6 Concrete tile 8 RMP (SR) 11 Other (specify)
 3 Water-tight sewer lines 6 Seepage pit 9 Feedyard 12 None used (open hole)
 SCREEN OR PERFORATION OPENINGS ARE: 25 1000's
 1 Continuous slot 3 Mill slot 5 Gauzed wrapped 8 Saw cut 11 None (open hole)
 2 Louvered shutter 4 Key punched 6 Wire wrapped 9 Drilled holes
 7 Torch cut 10 Other (specify)
 SCREEN-PERFORATED INTERVALS: From 100 ft. to 120 ft., From ft. to ft.
 GRAVEL PACK INTERVALS: From 25 ft. to 120 ft., From ft. to ft.

6 GROUT MATERIAL: 1 Neat cement 2 Cement grout 3 Bentonite 4 Other
 Grout Intervals: From 0 ft. to 25 ft., From ft. to ft., From ft. to ft.
 What is the nearest source of possible contamination:
 1 Septic tank 4 Lateral lines 7 Pit privy 10 Livestock pens 14 Abandoned water well
 2 Sewer lines 5 Cess pool 8 Sewage lagoon 11 Fuel storage 15 Oil well/Gas well
 3 Watertight sewer lines 6 Seepage pit 9 Feedyard 12 Fertilizer storage 16 Other (specify below)
 13 Insecticide storage
 Direction from well? North How many feet? 150'

FROM	TO	LITHOLOGIC LOG	FROM	TO	PLUGGING INTERVALS
0	1	Top Soil			
1	12	Sandy Clay			
12	26	Brown Clay			
26	27	Limestone			
27	46	Yellow Shale			
46	62	Limestone			
62	66	Grey Shale			
66	69	Limestone			
69	72	Grey Shale			
72	95	Limestone (Water)			
95	112	Brown Shale			
112	115	Limestone			
115	120'	Grey Shale			

7 CONTRACTOR'S OR LANDOWNER'S CERTIFICATION: This water well was (1) constructed, (2) reconstructed, or (3) plugged under my jurisdiction and was completed on (mo/day/year) 7/1 27/93 and this record is true to the best of my knowledge and belief. Kansas Water Well Contractor's License No. 451 This Water Well Record was completed on (mo/day/yr) 10/17/93 under the business name of Haldeman Well Drilling by (signature) [Signature]

INSTRUCTIONS: Use typewriter or ball point pen. PLEASE PRESS FIRMLY and PRINT clearly. Please fill in blanks, underline or circle the correct answers. Send top three copies to Kansas Department of Health and Environment, Bureau of Water, Topeka, Kansas 66620-0001. Telephone: 913-296-5545. Send one to WATER WELL OWNER and retain one for your records.