


1 LOCATION OF WATER WELL: County: Gary Fraction Se 1/4 No 1/4 No 1/4 Section Number 10 Township Number T 12 S Range Number R 5 E

Distance and direction from nearest town or city street address of well if located within city?  
From 77 & 18 Junction 2 1/2 W 1 1/2 S

2 WATER WELL OWNER: Harry Paquette  
 RR#, St. Address, Box #: 1238 W. 5th Ave  
 City, State, ZIP Code: Junction City, KS 66441  
 Board of Agriculture, Division of Water Resource Application Number:

3 LOCATE WELL'S LOCATION WITH AN "X" IN SECTION BOX:

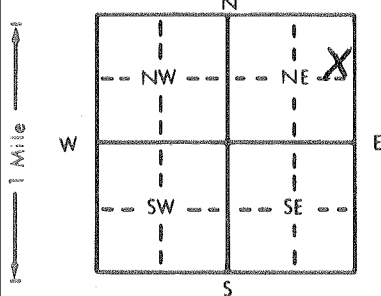

4 DEPTH OF COMPLETED WELL: 80 ft. ELEVATION:

Depth(s) Groundwater Encountered 1 65 ft. 2. . . . . ft. 3. . . . . ft.  
 WELL'S STATIC WATER LEVEL 42 ft. below land surface measured on 5-19-87  
 Pump test data: Well water was . . . . . ft. after . . . . . hours pumping . . . . . gpm  
 Est. Yield 30 gpm: Well water was . . . . . ft. after . . . . . hours pumping . . . . . gpm  
 Bore Hole Diameter 10 in. to 40 ft., and 7 in. to 80 ft.  
 WELL WATER TO BE USED AS: 5 Public water supply 8 Air conditioning 11 Injection well  
 1 Domestic 3 Feedlot 6 Oil field water supply 9 Dewatering 12 Other (Specify below)  
 2 Irrigation 4 Industrial 7 Lawn and garden only 10 Observation well  
 Was a chemical/bacteriological sample submitted to Department? Yes. . . . . No. X; If yes, mo/day/yr sample was submitted  
 Water Well Disinfected? Yes X No

5 TYPE OF BLANK CASING USED: 5 Wrought iron 8 Concrete tile CASING JOINTS: Glued X Clamped  
 1 Steel 3 RMP (SR) 6 Asbestos-Cement 9 Other (specify below) Welded  
 2 PVC 4 ABS 7 Fiberglass Threaded

Blank casing diameter 5 in. to 62 ft., Dia. . . . . in. to . . . . . ft., Dia. . . . . in. to . . . . . ft.  
 Casing height above land surface 10 in., weight CLASS 160 lbs./ft. Wall thickness or gauge No. 214

TYPE OF SCREEN OR PERFORATION MATERIAL: 7 PVC 10 Asbestos-cement  
 1 Steel 3 Stainless steel 5 Fiberglass 8 RMP (SR) 11 Other (specify)  
 2 Brass 4 Galvanized steel 6 Concrete tile 9 ABS 12 None used (open hole)

SCREEN OR PERFORATION OPENINGS ARE: 5 Gauzed wrapped 8 Saw cut 11 None (open hole)  
 1 Continuous slot 3 Mill slot 6 Wire wrapped 9 Drilled holes  
 2 Louvered shutter 4 Key punched 7 Torch cut 10 Other (specify)

SCREEN-PERFORATED INTERVALS: From 40 ft. to 80 ft., From . . . . . ft. to . . . . . ft.  
 From 62 ft. to 80 ft., From . . . . . ft. to . . . . . ft.  
 GRAVEL PACK INTERVALS: From 40 ft. to 80 ft., From . . . . . ft. to . . . . . ft.  
 From . . . . . ft. to . . . . . ft., From . . . . . ft. to . . . . . ft.

6 GROUT MATERIAL: 1 Neat cement 2 Cement grout 3 Bentonite 4 Other  
 Grout Intervals: From 16 ft. to 40 ft., From . . . . . ft. to . . . . . ft., From . . . . . ft. to . . . . . ft.

What is the nearest source of possible contamination:  
 1 Septic tank 4 Lateral lines 7 Pit privy 10 Livestock pens 14 Abandoned water well  
 2 Sewer lines 5 Cess pool 8 Sewage lagoon 11 Fuel storage 15 Oil well/Gas well  
 3 Watertight sewer lines 6 Seepage pit 9 Feedyard 12 Fertilizer storage 16 Other (specify below)  
 13 Insecticide storage  
 Direction from well? W How many feet? 100

FROM	TO	LITHOLOGIC LOG	FROM	TO	LITHOLOGIC LOG
0	4	Clay			
4	32	Sand			
32	35	Lime Stone			
35	65	Yellow Clay & Shale			
65	66	Water			
66	80	Yellow Shale			

7 CONTRACTOR'S OR LANDOWNER'S CERTIFICATION: This water well was (1) constructed, (2) reconstructed, or (3) plugged under my jurisdiction and was completed on (mo/day/year) 5-19-87 and this record is true to the best of my knowledge and belief. Kansas Water Well Contractor's License No. 180 This Water Well Record was completed on (mo/day/yr) 5-26-87 under the business name of Backhus Drilling by (signature) Paul Backhus