


1 LOCATION OF WATER WELL: County: Geary Fraction: SE 1/4 SE 1/4 NE 1/4 Section Number: 21 Township Number: T 12 S Range Number: R 5 E

Distance and direction from nearest town or city street address of well if located within city? From J.C. Go west 1.5 miles on I 70 T 77 then Go South 1/2 mile to old 40 + Go West 1.5 miles + 1/2 mile South

2 WATER WELL OWNER: Bob Hartung
 RR#, St. Address, Box #: RR#3 Box 44
 City, State, ZIP Code: J.C., KS 66441
 Board of Agriculture, Division of Water Resources
 Application Number:

3 LOCATE WELL'S LOCATION WITH AN "X" IN SECTION BOX:

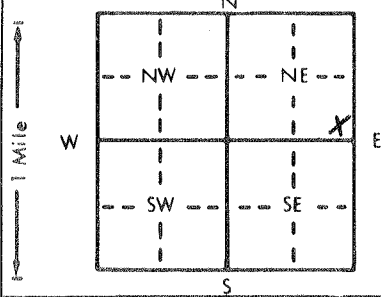

4 DEPTH OF COMPLETED WELL: 100' ft. ELEVATION:

Depth(s) Groundwater Encountered 1. 55 ft. 2. ft. 3. ft.
 WELL'S STATIC WATER LEVEL: 45 ft. below land surface measured on mo/day/yr
 Pump test data: Well water was ft. after hours pumping gpm
 Est. Yield: 1.5 gpm: Well water was ft. after hours pumping gpm
 Bore Hole Diameter: 9 in. to 100' ft., and in. to ft.

WELL WATER TO BE USED AS:
 1 Domestic 3 Feedlot 6 Oil field water supply 9 Dewatering 12 Other (Specify below)
 2 Irrigation 4 Industrial 7 Lawn and garden only 10 Monitoring well
 Was a chemical/bacteriological sample submitted to Department? Yes.....No.....; If yes, mo/day/yr sample was submitted Water Well Disinfected? Yes No

5 TYPE OF BLANK CASING USED:
 1 Steel 3 RMP (SR) 6 Asbestos-Cement 9 Other (specify below)
 2 PVC 4 ABS 7 Fiberglass
 CASING JOINTS: Gilded Clamped Welded Seamed

Blank casing diameter: 5 in. to 80' ft., Dia. in. to ft., Dia. in. to ft.
 Casing height above land surface: 2' in., weight Sch. 40 lbs./ft. Wall thickness or gauge No.

TYPE OF SCREEN OR PERFORATION MATERIAL:
 1 Steel 3 Stainless steel 5 Fiberglass 8 RMP (SR) 11 Other (specify)
 2 Brass 4 Galvanized steel 6 Concrete tile 9 ABS 12 None used (open hole)

SCREEN OR PERFORATION OPENINGS ARE:
 1 Continuous slot 3 Mill slot 1000's
 2 Louvered shutter 4 Key punched
 5 Gauzed wrapped 8 Saw cut 11 None (open hole)
 6 Wire wrapped 9 Drilled holes
 7 Torch cut 10 Other (specify)

SCREEN-PERFORATED INTERVALS: From 80 ft. to 100 ft., From ft. to ft., From ft. to ft.
 GRAVEL PACK INTERVALS: From 20 ft. to 100 ft., From ft. to ft., From ft. to ft.

6 GROUT MATERIAL: 1 Neat cement 2 Cement grout 3 Bentonite 4 Other
 Grout Intervals: From 0 ft. to 20 ft., From ft. to End of plug, From ft. to ft.

What is the nearest source of possible contamination: Water
 1 Septic tank 4 Lateral lines 7 Pit privy
 2 Sewer lines 5 Cess pool 8 Sewage lagoon 10 Livestock pens 14 Abandoned water well
 3 Watertight sewer lines 6 Seepage pit 9 Feedyard 11 Fuel storage 15 Oil well/Gas well
 12 Fertilizer storage 16 Other (specify below)
 13 Insecticide storage

Direction from well? 300' How many feet? Wisy

FROM	TO	LITHOLOGIC LOG	FROM	TO	PLUGGING INTERVALS
0	17	Brown Clay			
17	28	Sandy Clay			
28	33	Brown shale			
33	38	Limestone			
38	39	Greenish shale			
39	47	Limestone			
47	55	Grey shale			
55	73	Limestone (Water)			
73	94	Grey shale			
94	96	Limestone			
96	100	Grey shale			

7 CONTRACTOR'S OR LANDOWNER'S CERTIFICATION: This water well was (1) constructed, (2) reconstructed, or (3) plugged under my jurisdiction and was completed on (mo/day/year) 5/21/91 and this record is true to the best of my knowledge and belief. Kansas Water Well Contractor's License No. 451 This Water Well Record was completed on (mo/day/yr) 5/28/91 under the business name of Holdeman Well Drilling by (signature) Craig Culp