USE TYPEWRITER OR BALL POINT PEN-PRESS FIRMLY, PRINT CLEARLY.

T	R	EW	sec 1/4	1/4	1/4 No.

WATER WELL RECORD
KSA 82a-1201-1215

Kansas State Dept. Of Health
(Water Well Contractors)
Forbes-Bldg. 740
Topeka, Kansas 66620

1 Location of well:	County	Township name	Fraction	Section number	Town number	Range number
	Geary	Lyons	NW¼ of SW¼ of SE¼	24	12S	5E

Distance and direction from nearest town or city: South 4½ miles from Junction City, Kansas
Street address of well location if in city:

3 Owner of well: Stanley Mikolaszuk
Address: 335th Aviation Company Ft. Riley, Kansas

7-15-75

Locate with "X" in section below:

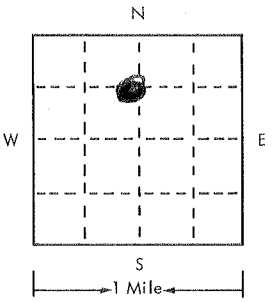

Sketch map:

4 Well depth: 120 ft. Date of completion 15 July 75
Well diameter 9" in.

5 [X] Cable tool [ ] Rotary [ ] Driven [ ] Dug
[ ] Hollow rod [ ] Jetted [ ] Bored [ ] Reverse rotary

6 Use: [X] Domestic [ ] Public supply [ ] Industry
[ ] Irrigation [ ] Air conditioning [ ] Commercial
[ ] Test well [ ]

7 Casing: Material [ ] Height: above/below RMP
Threaded [ ] Welded [ ] Surface
Diam. 5 in. to 120 ft. depth Weight 15# lbs./ft.
Drive shoe? [ ] Yes [X] No
in. to ft. depth

8 Screen: RMP
Manufacturer JESS + LOWELL
Type PLASTIC Dia. 5 inch
Slot/gauze .080 Length 20 ft.
Set between 90 ft. and 110 ft.
Fittings:
Gravel pack [X] Yes [ ] No Size range of material 1/4 X 1/8

9 Static water level: July 15 1975
95 ft. below land surface Date July 15

10 Pumping level below land surfaces:
ft. after hrs. pumping g.p.m.
ft. after hrs. pumping g.p.m.
Estimated maximum yield 7 g.p.m.

11 Water sample submitted:
[ ] Yes [X] No Date

12 Well head completion:
[ ] Pitless adapter N/A [ ] 12 Inches above grade

13 Well grouted? [X] Yes [ ] No
[X] Neat cement [ ] Bentonite [ ]
Depth: From 10 ft. to 20 ft.

14 Nearest source of possible contamination: House
ft. 1950 Direction east
Well disinfected upon completion? [X] Yes [ ] No

15 Pump: [X] Not installed
Manufacturer's name
Model number HP Volts
Length of drop pipe ft. capacity g.m.p.
Type:
[ ] Submersible [ ] Turbine
[ ] Jet [ ] Reciprocating
[ ] Certrifugal [ ] Other

2 Type and color of material	From	To
Top Soil	0	6
Yellow Clay	6	12
Yellow Lime Rock	12	20
Blue Shale	20	35
Yellow Lime + Flint Rock	35	45
Blue Rock	45	70
Yellow Lime Rock	70	82
Blue Shale	82	85
Red Shale	85	92
White Lime Stone	92	96
Blue Shale	96	120

(use a second sheet if needed)

16 Remarks: elevation

Topography:
[ ] Hill
[X] Slope
[ ] Upland
[ ] Valley

17 Water well contractor's certification:
This well was drilled under my jurisdiction and this report is true to the best of my knowledge and belief.
Strader Drilling
Business name License No.
Address BLUE RAPIDS
Signed Harold Strader Date July 15
Authorized representative

Forward the white, blue and pink copies to the Kansas State Dept. Of Health.

Form WWC-5