


1 LOCATION OF WATER WELL: Fraction NC 1/4 NC 1/4 NC 1/4 Section Number 28 Township Number T 12 S Range Number R 5 EW

Distance and direction from nearest town or city street address of well if located within city? From Junction City Co 1 mile west on E 70 to 77 then go to south on 77 to old 40, 60 1 3/4 miles west on old 40 to 60 3/4 south on R 5

2 WATER WELL OWNER: Mr. Joe V. Brit
 RR#, St. Address, Box #: Route 3 Box 62
 City, State, ZIP Code: Junction City, Kansas 66441

Board of Agriculture, Division of Water Resources
 Application Number:

3 LOCATE WELL'S LOCATION WITH AN "X" IN SECTION BOX:

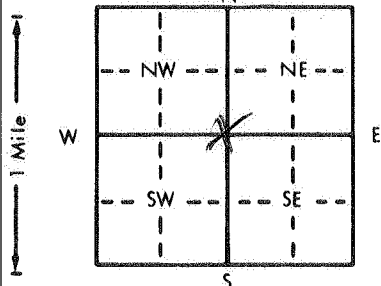

4 DEPTH OF COMPLETED WELL: 100' ft. ELEVATION:

Depth(s) Groundwater Encountered 1. 75' ft. 2. ft. 3. ft.
 WELL'S STATIC WATER LEVEL 70' ft. below land surface measured on mo/day/yr
 Pump test data: Well water was ft. after hours pumping gpm
 Est. Yield 15 gpm: Well water was ft. after hours pumping gpm
 Bore Hole Diameter 8 in. to 100' ft., and in. to ft.
 WELL WATER TO BE USED AS:
 1 Domestic 3 Feedlot 6 Oil field water supply 9 Dewatering 12 Other (Specify below)
 2 Irrigation 4 Industrial 7 Lawn and garden only 10 Observation well
 Was a chemical/bacteriological sample submitted to Department? Yes No; If yes, mo/day/yr sample was submitted
 Water Well Disinfected? Yes No

5 TYPE OF BLANK CASING USED:
 1 Steel 3 RMP (SR) 6 Asbestos-Cement 9 Other (specify below)
 2 PVC 4 ABS 7 Fiberglass

Blank casing diameter 5 1/2 in. to 80' ft., Dia. 1 1/2 in. to ft., Dia. in. to ft.
 Casing height above land surface 2' in., weight Sch 40 lbs./ft. Wall thickness or gauge No.

TYPE OF SCREEN OR PERFORATION MATERIAL:
 1 Steel 3 Stainless steel 5 Fiberglass 7 PVC 10 Asbestos-cement
 2 Brass 4 Galvanized steel 6 Concrete tile 8 RMP (SR) 11 Other (specify)
 12 None used (open hole)

SCREEN OR PERFORATION OPENINGS ARE:
 1 Continuous slot 3 Mill slot 3/1000's 5 Gauzed wrapped 8 Saw cut 11 None (open hole)
 2 Louvered shutter 4 Key punched 6 Wire wrapped 9 Drilled holes
 7 Torch cut 10 Other (specify)

SCREEN-PERFORATED INTERVALS: From 80' ft. to 100' ft., From ft. to ft., From ft. to ft.
 GRAVEL PACK INTERVALS: From 20' ft. to 100' ft., From ft. to ft., From ft. to ft.

6 GROUT MATERIAL: 1 Neat cement 2 Cement grout 3 Bentonite 4 Other
 Grout Intervals: From 0 ft. to 20 ft., From ft. to ft., From ft. to ft.

What is the nearest source of possible contamination: None Close
 1 Septic tank 4 Lateral lines 7 Pit privy 10 Livestock pens 14 Abandoned water well
 2 Sewer lines 5 Cess pool 8 Sewage lagoon 11 Fuel storage 15 Oil well/Gas well
 3 Watertight sewer lines 6 Seepage pit 9 Feedyard 12 Fertilizer storage 16 Other (specify below)
 13 Insecticide storage

Direction from well? How many feet?

FROM	TO	LITHOLOGIC LOG	FROM	TO	LITHOLOGIC LOG
0	22	Brown clay	87	93	Shale gray
22	26	Red clay	93	95	Rock
26	28	Rock	95	100	Blue shale
28	31	Brown clay			
31	33	Gray clay			
33	36	Rock			
36	45	Gray shale			
45	51	Rock			
51	55	Gray shale			
55	57	Rock			
57	62	Gray shale			
62	63	Rock			
63	72	Gray shale			
72	75	Brown shale			
75	87	Rock (water)			

7 CONTRACTOR'S OR LANDOWNER'S CERTIFICATION: This water well was (1) constructed, (2) reconstructed, or (3) plugged under my jurisdiction and was completed on (mo/day/year) 4/28/88 and this record is true to the best of my knowledge and belief. Kansas Water Well Contractor's License No. 451 This Water Well Record was completed on (mo/day/yr) 5/29/88 under the business name of Holdeman Well Drilling by (signature) Wally Holdeman