


1 LOCATION OF WATER WELL: Fraction SE 1/4 SW 1/4 NE 1/4 Section Number 29 Township Number T 12 S Range Number R 5

Distance and direction from nearest town or city street address of well if located within city?
8 miles East & 1 1/2 miles South of Chapman, KS

2 WATER WELL OWNER: John Witt
RR#, St. Address, Box #: RR 2, Box 224A
City, State, ZIP Code: Chapman, KS 67431
Board of Agriculture, Division of Water Resources
Application Number: 38,749

3 LOCATE WELL'S LOCATION WITH AN "X" IN SECTION BOX:

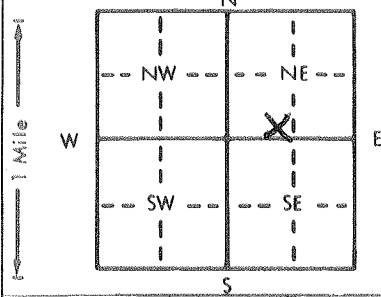

4 DEPTH OF COMPLETED WELL: 47 ft. ELEVATION: ...
Depth(s) Groundwater Encountered 1. 9 ft. 2. ... ft. 3. ... ft.

WELL'S STATIC WATER LEVEL: 9 ft. below land surface measured on mo/day/yr 6-14-88
Pump test data: Well water was ... ft. after ... hours pumping ... gpm
Est. Yield 500 gpm: Well water was ... ft. after ... hours pumping ... gpm
Bore Hole Diameter: 30 in. to 47 ft., and ... in. to ... ft.
WELL WATER TO BE USED AS:
5 Public water supply 8 Air conditioning 11 Injection well
1 Domestic 3 Feedlot 6 Oil field water supply 9 Dewatering 12 Other (Specify below)
2 Irrigation 4 Industrial 7 Lawn and garden only 10 Observation well
Was a chemical/bacteriological sample submitted to Department? Yes...No...X...; If yes, mo/day/yr sample was submitted
Water Well Disinfected? Yes X No

5 TYPE OF BLANK CASING USED:
1 Steel 3 RMP (SR) 5 Wrought iron 8 Concrete tile CASING JOINTS: Glued ... Clamped ...
2 PVC 4 ABS 6 Asbestos-Cement 9 Other (specify below) Welded ...
7 Fiberglass Threaded ...

Blank casing diameter: 16 in. to 26 ft., Dia ... in. to ... ft., Dia ... in. to ... ft.
Casing height above land surface: 12 in., weight 32 lbs./ft. Wall thickness or gauge No. 75

TYPE OF SCREEN OR PERFORATION MATERIAL:
1 Steel 3 Stainless steel 5 Fiberglass 7 PVC 10 Asbestos-cement
2 Brass 4 Galvanized steel 6 Concrete tile 8 RMP (SR) 11 Other (specify) ...
12 None used (open hole)

SCREEN OR PERFORATION OPENINGS ARE:
1 Continuous slot 3 Mill slot 5 Gauzed wrapped 8 Saw cut 11 None (open hole)
2 Louvered shutter 4 Key punched 6 Wire wrapped 9 Drilled holes
7 Torch cut 10 Other (specify) 1/8" Slot

SCREEN-PERFORATED INTERVALS: From 21 ft. to 47 ft., From ... ft. to ... ft.
GRAVEL PACK INTERVALS: From 20 ft. to 47 ft., From ... ft. to ... ft.

6 GROUT MATERIAL: 1 Neat cement 2 Cement grout 3 Bentonite 4 Other ...
Grout Intervals: From 0 ft. to 20 ft., From ... ft. to ... ft., From ... ft. to ... ft.

What is the nearest source of possible contamination:
1 Septic tank 4 Lateral lines 7 Pit privy 10 Livestock pens 14 Abandoned water well
2 Sewer lines 5 Cess pool 8 Sewage lagoon 11 Fuel storage 15 Oil well/Gas well
3 Watertight sewer lines 6 Seepage pit 9 Feedyard 12 Fertilizer storage 16 Other (specify below)
13 Insecticide storage
Direction from well? North East How many feet? 1/2 mile

FROM	TO	LITHOLOGIC LOG	FROM	TO	LITHOLOGIC LOG
0	4	Top Soil			
4	10	Clay Gray			
10	26	Sand - Medium			
26	47	Sand - Medium to Coarse			
47	48	Hard Limestone			

7 CONTRACTOR'S OR LANDOWNER'S CERTIFICATION: This water well was (1) constructed, (2) reconstructed, or (3) plugged under my jurisdiction and was completed on (mo/day/year) 6-14-88 and this record is true to the best of my knowledge and belief. Kansas Water Well Contractor's License No. 138 This Water Well Record was completed on (mo/day/yr) 6-14-88 under the business name of Peterson Irrigation, Inc. by (signature) Mike Peterson

INSTRUCTIONS: Use typewriter or ball point pen. PLEASE PRESS FIRMLY and PRINT clearly. Please fill in blanks, underline or circle the correct answers. Send top three copies to Kansas Department of Health and Environment, Bureau of Water Protection, Topeka, Kansas 66620-7320, Telephone: 913-862-9360. Send one to WATER WELL OWNER and retain one for your records.