


WATER WELL RECORD Form WWC-5 KSA 82a-1212

1 LOCATION OF WATER WELL: County: GEARY Fraction: N 1/4 SE 1/4 NE 1/4 Section Number: 35 Township Number: T 12 S Range Number: R 5 E

2 WATER WELL OWNER: Charles Casper Jr. RR#, St. Address, Box #: RR #1 Box 100-B City, State, ZIP Code: JUNCTION CITY, KANSAS 66441

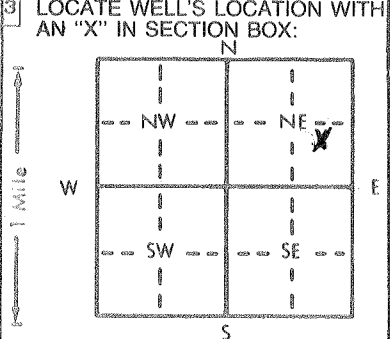

3 LOCATE WELL'S LOCATION WITH AN "X" IN SECTION BOX: 4 DEPTH OF COMPLETED WELL: 50 ft. ELEVATION: ... Depth(s) Groundwater Encountered 1. 30 ft. 2. ... ft. 3. ... ft. WELL'S STATIC WATER LEVEL: 30 ft. below land surface measured on mo/day/yr ...

5 TYPE OF BLANK CASING USED: 1 Steel, 2 PVC, 3 RMP (SR), 4 ABS, 5 Wrought iron, 6 Asbestos-Cement, 7 Fiberglass, 8 Concrete tile, 9 Other (specify below) CASING JOINTS: Glued, Welded, Clamped, Threaded

TYPE OF SCREEN OR PERFORATION MATERIAL: 1 Steel, 2 Brass, 3 Stainless steel, 4 Galvanized steel, 5 Fiberglass, 6 Concrete tile, 8 RMP (SR), 9 ABS, 10 Asbestos-cement, 11 Other (specify), 12 None used (open hole)

SCREEN OR PERFORATION OPENINGS ARE: 1 Continuous slot, 2 Louvered shutter, 3 Mill slot 16/1000s, 4 Key punched, 5 Gauzed wrapped, 6 Wire wrapped, 7 Torch cut, 8 Saw cut, 9 Drilled holes, 10 Other (specify), 11 None (open hole)

SCREEN-PERFORATED INTERVALS: From 30 ft. to 50 ft. GRAVEL PACK INTERVALS: From 20 ft. to 50 ft.

6 GROUT MATERIAL: 1 Neat cement, 2 Cement grout, 3 Bentonite, 4 Other Grout Intervals: From 0 ft. to 20 ft. What is the nearest source of possible contamination: 4 Lateral lines, 7 Pit privy, 10 Livestock pens, 14 Abandoned water well

FROM	TO	LITHOLOGIC LOG	FROM	TO	PLUGGING INTERVALS
<u>0</u>	<u>30</u>	<u>Brown clay</u>			
<u>30</u>	<u>48</u>	<u>Gravel</u>			
<u>48</u>	<u>60</u>	<u>Gray shale</u>			

7 CONTRACTOR'S OR LANDOWNER'S CERTIFICATION: This water well was (1) constructed, (2) reconstructed, or (3) plugged under my jurisdiction and was completed on (mo/day/year) 12/10/88 and this record is true to the best of my knowledge and belief. Kansas Water Well Contractor's License No. 451 This Water Well Record was completed on (mo/day/yr) 2/8/89 under the business name of Holdsman Well Drilling by (signature) Craig H.