


1 LOCATION OF WATER WELL: Fraction	Section Number	Township Number	Range Number
County: <b>Geary</b> NE ¼ NE ¼ NW ¼	<b>1</b>	<b>12S</b>	<b>5E</b>

Distance and direction from nearest town or city street address of well if located within city?  
**370 Grant Avenue, Junction City**

2 WATER WELL OWNER: **ATOFINA Petrochemicals, Inc.**  
 RR#, St. Address, Box # **P.O. Box 674411** Board of Agriculture, Division of Water Resources  
 City, State, ZIP Code : **Houston, Texas 77267-4411** Application Number:

3 MARK WELL'S LOCATOR WITH AN "X" IN SECTION BOX:

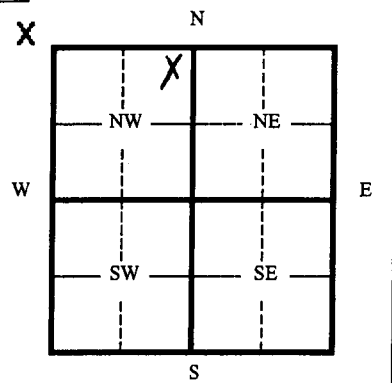

4 DEPTH OF WELL **45** ft.  
 WELL'S STATIC WATER LEVEL **Unknown** ft.  
 WELL WAS USED AS:  
 1 Domestic 5 Public Water Supply 9 Dewatering  
 2 Irrigation 6 Oil Field Water Supply 10 **Monitoring Well**  
 3 Feedlot 7 Lawn and Garden (domestic) 11 Injection Well  
 4 Industrial 8 Air Conditioning 12 Other \_\_\_\_\_  
 Was a chemical/bacteriological sample submitted to Department? Yes \_\_\_ No **X**  
 If yes, mo/day/yr sample was submitted \_\_\_\_\_  
 Water Well Disinfected: Yes \_\_\_ No **X**

5 TYPE OF BLANK CASING USED:  
 1 Steel 3 RMP (SR) 5 Wrought 7 Fiberglass 9 Other (specify below)  
 2 **PVC** 4 ABC 6 Asbestos-Cement 8 Concrete Tile  
 Blank casing diameter **1** in. Was casing pulled? Yes **X** No \_\_\_ If yes, how much **45 ft. (including screen)**  
 Casing height above or below land surface **0** in.

6 GROUT PLUG MATERIAL: 1 Neat cement 2 Cement grout 3 **Bentonite** 4 Other \_\_\_\_\_  
 Grout Plug Intervals From **0.5** ft. to **45** ft. From \_\_\_\_\_ ft. to \_\_\_\_\_ ft. From \_\_\_\_\_ ft. to \_\_\_\_\_ ft.  
 What is the nearest source of possible contamination:  
 1 Septic tank 6 Seepage pit 11 **Fuel storage** 16 Other (specify below)  
 2 Sewer lines 7 Pit privy 12 Fertilizer storage  
 3 Watertight sewer lines 8 Sewage lagoon 13 Insecticide storage  
 4 Lateral lines 9 Feedyard 14 Abandoned water well  
 5 Cess Pool 10 Livestock pens 15 Oil well/ Gas well

Direction from well? **Unknown** How many feet? **Unknown**

FROM	TO	CODE	PLUGGING MATERIALS
0	0.5		<b>Compacted clay or concrete</b>
0.5	45		<b>Bentonite</b>

7 CONTRACTOR'S OR LANDOWNER'S CERTIFICATION: This water well was plugged under my jurisdiction and was completed on (mo/day/yr) **11/8/04** and this record is true to the best of my knowledge and belief. Kansas Water Well Contractor's License No. **616** This Water Well Record was completed on (mo/day/yr) **12/29/04** under the business name of **Thiele Geotech, Inc.**  
 by (signature) *D. J. [Signature]*

INSTRUCTIONS: Please fill in blanks and circle the correct answers. Send three copies to Kansas Department of Health and Environment, Bureau of Water, Topeka, Kansas 66620-0001. Telephone: 785-296-3565. Send one to Water Well Owner and retain one for your records.