

WATER WELL PLUGGING RECORD

FORM WWC-5P

KSA 82a-1212


1 LOCATION OF WATER WELL: Fraction -	Section Number	Township Number	Range Number
County: Geary NE ¼ NE ¼ NW ¼	1	12S	5E

Distance and direction from nearest town or city street address of well if located within city?

370 Grant Avenue, Junction City

2 WATER WELL OWNER: ATOFINA Petrochemicals, Inc.	Board of Agriculture, Division of Water Resources
RR#, St. Address, Box # P.O. Box 674411	Application Number:
City, State, ZIP Code : Houston, Texas 77267-4411	

3 MARK WELL'S LOCATION WITH AN "X" IN SECTION BOX:

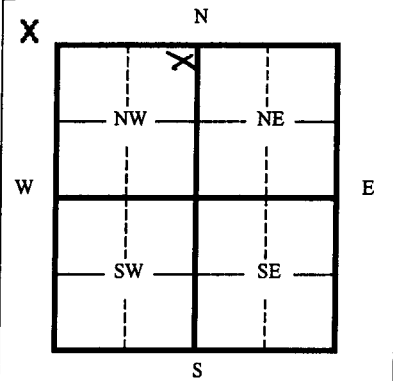

4 DEPTH OF WELL **46** ft.

WELL'S STATIC WATER LEVEL **Unknown** ft.

WELL WAS USED AS:

- | | | |
|--------------|------------------------------|---------------------------|
| 1 Domestic | 5 Public Water Supply | 9 Dewatering |
| 2 Irrigation | 6 Oil Field Water Supply | 10 Monitoring Well |
| 3 Feedlot | 7 Lawn and Garden (domestic) | 11 Injection Well |
| 4 Industrial | 8 Air Conditioning | 12 Other |

Was a chemical/bacteriological sample submitted to Department? Yes ___ No **X**

If yes, mo/day/yr sample was submitted

Water Well Disinfected: Yes ___ No **X**

5 TYPE OF CASING USED:

- | | | | | |
|--------------|------------|-------------------|-----------------|-------------------------|
| 1 Steel | 3 RMP (SR) | 5 Wrought | 7 Fiberglass | 9 Other (specify below) |
| 2 PVC | 4 ABC | 6 Asbestos-Cement | 8 Concrete Tile | |

Blank casing diameter **5** in. Was casing pulled? Yes **X** No ___ If yes, how much **46 ft. (including screen)**

Casing height above or below land surface **0** in.

6 GROUT PLUG MATERIAL: 1 Neat cement 2 Cement grout **3 Bentonite** 4 Other

Grout Plug Intervals From **0.5** ft. to **46** ft. From _____ ft. to _____ ft. From _____ ft. to _____ ft.

What is the nearest source of possible contamination:

- | | | | |
|--------------------------|-------------------|-------------------------|--------------------------|
| 1 Septic tank | 6 Seepage pit | 11 Fuel storage | 16 Other (specify below) |
| 2 Sewer lines | 7 Pit privy | 12 Fertilizer storage | |
| 3 Watertight sewer lines | 8 Sewage lagoon | 13 Insecticide storage | |
| 4 Lateral lines | 9 Feedyard | 14 Abandoned water well | |
| 5 Cess Pool | 10 Livestock pens | 15 Oil well/ Gas well | |

Direction from well? **West** How many feet? **60**

FROM	TO	CODE	PLUGGING MATERIALS
0	0.5		Compacted clay or concrete
0.5	46		Bentonite

7 CONTRACTOR'S OR LANDOWNER'S CERTIFICATION: This water well was plugged under my jurisdiction and was completed on (mo/day/yr) **11/8/04** and this record is true to the best of my knowledge and belief. Kansas Water Well Contractor's License No. **616** This Water Well Record was completed on (mo/day/yr) **12/29/04** under the business name of **Thiele Geotech, Inc.** by (signature) *D. J. [Signature]*

INSTRUCTIONS: Please fill in blanks and circle the correct answers. Send three copies to Kansas Department of Health and Environment, Bureau of Water, Topeka, Kansas 66620-0001. Telephone: 785-296-3565. Send one to Water Well Owner and retain one for your records.