

CORRECTION(S) TO WATER WELL RECORD (WWC-5)
(to rectify lacking or incorrect information)

County: Geary

Location listed as:

Location changed to:

Section-Township-Range: 11-12S-5E

1-12S-5E

Fraction (1/4 1/4 1/4): unknown

NW NW NW NE

Other changes: Initial statements: _____

Changed to: _____

Comments: Location was given as Special Section 11 - T12S-R5E, which is OK, but I projected regular PLSS over this area.

verification method: wellsite address, city street map, and Junction City 1:24,000 topo map.

initials: DRB date: 7/19/2012

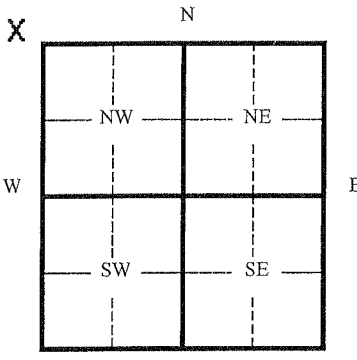
submitted by: Kansas Geological Survey, Data Resources Library, 1930 Constant Ave., Lawrence, KS 66047-3726
to: Kansas Dept of Health & Environment, Bureau of Water, 1000 SW Jackson, Suite 420, Topeka, KS 66612-1367.

1	LOCATION OF WATER WELL: Fraction	Section Number	Township Number	Range Number
County: Geary	Unk. 1/4 Unk. 1/4 Unk. 1/4	11	12S	5E

Distance and direction from nearest town or city street address of well if located within city?

370 (350) Grant Avenue, Junction City

2	WATER WELL OWNER: ATOFINA Petrochemicals, Inc.	Board of Agriculture, Division of Water Resources
RR#, St. Address, Box #	P.O. Box 674411	Application Number:
City, State, ZIP Code	Houston, Texas 77267-4411	

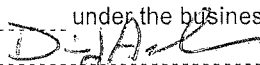
3	MARK WELL'S LOCATON WITH AN "X" IN SECTION BOX: 	4	DEPTH OF WELL 40 ft.
		WELL'S STATIC WATER LEVEL Unknown ft.	
WELL WAS USED AS:			
1 Domestic 5 Public Water Supply 9 Dewatering 2 Irrigation 6 Oil Field Water Supply 10 Monitoring Well 3 Feedlot 7 Lawn and Garden (domestic) 11 Injection Well 4 Industrial 8 Air Conditioning 12 Other _____			
Was a chemical/bacteriological sample submitted to Department? Yes _____ No X			
If yes, mo/day/yr sample was submitted _____			
Water Well Disinfected: Yes _____ No X			

5	TYPE OF BLANK CASING USED:
1 Steel	3 RMP (SR)
2 PVC	4 ABC
5 Wrought	7 Fiberglass
6 Asbestos-Cement	8 Concrete Tile
9 Other (specify below)	
Blank casing diameter 2 in.	Was casing pulled? Yes X No _____ If yes, how much 40 ft. (including screen)
Casing height above or below land surface 0 in.	

6	GROUT PLUG MATERIAL: 1 Neat cement 2 Cement grout 3 Bentonite 4 Other _____
Grout Plug Intervals	From 0.5 ft. to 40 ft. From _____ ft. to _____ ft. From _____ ft. to _____ ft.
What is the nearest source of possible contamination:	
1 Septic tank	6 Seepage pit
2 Sewer lines	7 Pit privy
3 Watertight sewer lines	8 Sewage lagoon
4 Lateral lines	9 Feedyard
5 Cess Pool	10 Livestock pens
11 Fuel storage	16 Other (specify below)
12 Fertilizer storage	
13 Insecticide storage	
14 Abandoned water well	
15 Oil well/ Gas well	

Direction from well? **Unknown** How many feet? **Unknown**

FROM	TO	CODE	PLUGGING MATERIALS
0	0.5		Compacted clay or concrete
0.5	40		Bentonite

7	CONTRACTOR'S OR LANDOWNER'S CERTIFICATION: This water well was plugged under my jurisdiction and was completed on (mo/day/yr) 11/8/04 and this record is true to the best of my knowledge and belief. Kansas Water Well Contractor's License No. 616 This Water Well Record was completed on (mo/day/yr) 12/29/04 under the business name of Thiele Geotech, Inc.
by (signature)	

INSTRUCTIONS: Please fill in blanks and circle the correct answers. Send three copies to Kansas Department of Health and Environment, Bureau of Water, Topeka, Kansas 66620-0001. Telephone: 785-296-3565. Send one to Water Well Owner and retain one for your records.