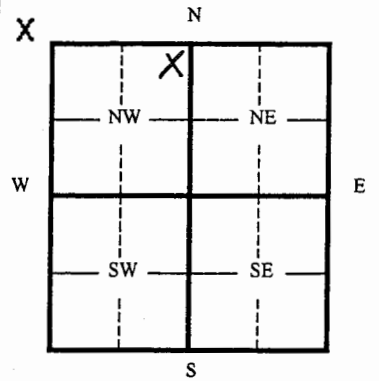


1 LOCATION OF WATER WELL: Fraction **NE 1/4 NE 1/4 NW 1/4** Section Number **1** Township Number **12S** Range Number **5E**
 County: **Geary**

Distance and direction from nearest town or city street address of well if located within city?
370 (350) Grant Avenue, Junction City

2 WATER WELL OWNER: **ATOFINA Petrochemicals, Inc.**
 RR#, St. Address, Box # **P.O. Box 674411** Board of Agriculture, Division of Water Resources
 City, State, ZIP Code : **Houston, Texas 77267-4411** Application Number:

3 MARK WELL'S LOCATON WITH AN "X" IN SECTION BOX:


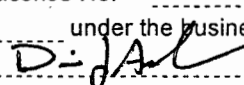
4 DEPTH OF WELL **33** ft.
 WELL'S STATIC WATER LEVEL **Unknown** ft.
 WELL WAS USED AS:
 1 Domestic 5 Public Water Supply 9 Dewatering
 2 Irrigation 6 Oil Field Water Supply 10 **Monitoring Well**
 3 Feedlot 7 Lawn and Garden (domestic) 11 Injection Well
 4 Industrial 8 Air Conditioning 12 Other _____
 Was a chemical/bacteriological sample submitted to Department? Yes _____ No **X**
 If yes, mo/day/yr sample was submitted _____
 Water Well Disinfected: Yes _____ No **X**

5 TYPE OF BLANK CASING USED:
 1 Steel 3 RMP (SR) 5 Wrought 7 Fiberglass 9 Other (specify below)
 2 **PVC** 4 ABC 6 Asbestos-Cement 8 Concrete Tile
 Blank casing diameter **2** in. Was casing pulled? Yes **X** No _____ If yes, how much **33** ft.
 Casing height above or below land surface **0** in.

6 GROUT PLUG MATERIAL: 1 Neat cement 2 Cement grout **3 Bentonite** 4 Other _____
 Grout Plug Intervals From **0.5** ft. to **33** ft. From _____ ft. to _____ ft. From _____ ft. to _____ ft.
 What is the nearest source of possible contamination:
 1 Septic tank 6 Seepage pit 11 **Fuel storage** 16 Other (specify below)
 2 Sewer lines 7 Pit privy 12 Fertilizer storage
 3 Watertight sewer lines 8 Sewage lagoon 13 Insecticide storage
 4 Lateral lines 9 Feedyard 14 Abandoned water well
 5 Cess Pool 10 Livestock pens 15 Oil well/ Gas well

Direction from well? **N** How many feet? **40**

FROM	TO	CODE	PLUGGING MATERIALS
0	0.5		Compacted clay or concrete
0.5	33		Bentonite

7 CONTRACTOR'S OR LANDOWNER'S CERTIFICATION: This water well was plugged under my jurisdiction and was completed on (mo/day/yr) **11/8/04** and this record is true to the best of my knowledge and belief. Kansas Water Well Contractor's License No. **616** This Water Well Record was completed on (mo/day/yr) **1/25/05** under the business name of **Thiele Geotech, Inc.**
 by (signature) 

INSTRUCTIONS: Please fill in blanks and circle the correct answers. Send three copies to Kansas Department of Health and Environment, Bureau of Water, Topeka, Kansas 66620-0001. Telephone: 785-296-3565. Send one to Water Well Owner and retain one for your records.