


1 LOCATION OF WATER WELL: Fraction Section Number Township Number Range Number  
 County: Greary NE 1/4 SE 1/4 NE 1/4 4 1/4 12 5 5 (E/W)

Distance and direction from nearest town or city street address of well if located within city?  
From Hwy 18 & Spring Valley Rd., go North 3/4 mile, west side of Rd.

2 WATER WELL OWNER: Scott Bird  
 RR #, St. Address, Box #: 2424 N. Spring Valley Rd Board of Agriculture, Division of Water Resources  
 City, State, ZIP Code: Junction City, KS, 66441 Application Number: \_\_\_\_\_

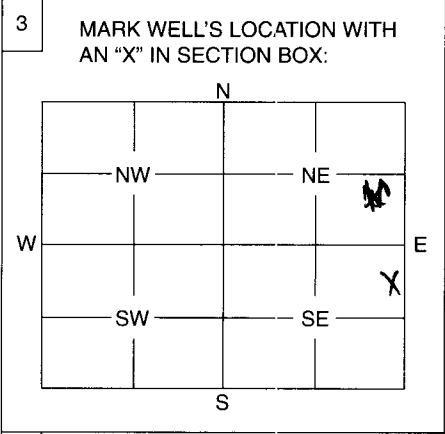

4 DEPTH OF WELL 235 ft.  
 WELL'S STATIC WATER LEVEL 120 ft.  
 WELL WAS USED AS:  
 1 Domestic      5 Public Water Supply      9 Dewatering  
 2 Irrigation      6 Oil Field Water Supply      10 Monitoring Well  
 3 Feedlot      7 Domestic (Lawn & Garden)      11 Injection Well  
 4 Industrial      8 Air Conditioning      12 Other \_\_\_\_\_  
 Was a chemical / bacteriological sample submitted to Department? Yes \_\_\_\_\_ No   
 If yes, mo/day/yr sample was submitted \_\_\_\_\_  
 Water Well Disinfected: Yes  No \_\_\_\_\_

5 TYPE OF BLANK CASING USED:  
 1 Steel      3 RMP (SR)      5 Wrought      7 Fiberglass      9 Other (Specify below)  
 2 PVC      4 ABS      6 Asbestos-Cement      8 Concrete Tile  
 Blank casing diameter 5 in. Was casing pulled? Yes \_\_\_\_\_ No   
 Casing height above or below land surface 36" in. If yes, how much \_\_\_\_\_

6 GROUT PLUG MATERIAL: 1 Neat cement      2 Cement grout      3 Bentonite      4 Other \_\_\_\_\_  
 Grout Plug Intervals: From 0 ft. to 235 ft., From \_\_\_\_\_ ft. to \_\_\_\_\_ ft., From \_\_\_\_\_ to \_\_\_\_\_ ft.  
 What is the nearest source of possible contamination:  
 1 Septic tank      6 Seepage pit      11 Fuel storage      16 Other (specify below)  
 2 Sewer lines      7 Pit privy      12 Fertilizer storage  
 3 Water-tight sewer lines      8 Sewage lagoon      13 Insecticide storage  
 4 Lateral lines      9 Feedyard      14 Abandoned water well  
 5 Cess pool      10 Livestock pens      15 Oil well/Gas well  
 Direction from well? West How many feet? 200' +

FROM	TO	PLUGGING MATERIALS

7 CONTRACTOR'S OF LANDOWNER'S CERTIFICATION: This water well was plugged under my jurisdiction and was completed on (mo/day/year) 11.15.07 and this record is true to the best of my knowledge and belief. Kansas Water Well Contractor's License No. N/A This Water Well Record was completed on (mo/day/year) 11.15.07 under the business name of JJK Contracting L.C. by (signature) [Signature]

INSTRUCTIONS: Use typewriter or ball point pen. Please press firmly and print clearly. Please fill in blanks, underline or circle the correct answers. Send top three copies to Kansas Department of Health and Environment, Bureau of Water, Geology Section, 1000 SW Jackson St., Ste. 420, Topeka, Kansas 66612-1367. Telephone: 785/296-5522. Send one to Water Well Owner and retain one for your records.