


1	LOCATION OF WATER WELL:	Fraction	Section	Number	Township	Number	Range	Number
	County: <u>Geary</u>	<u>NE 1/4 NE 1/4 SE 1/4</u>	<u>4</u>	<u>1/4</u>	<u>12</u>	<u>S</u>	<u>5</u>	<u>EW</u>

Distance and direction from nearest town or city street address of well if located within city?
From Hwy 18 & Spring Valley Rd, 40 north 1/4 mile, west side of road

2	WATER WELL OWNER: <u>Stephen Manns</u>	Board of Agriculture, Division of Water Resources
	RR #, St. Address, Box #: <u>1810 N. Spring Valley Rd.</u>	Application Number:
	City, State, ZIP Code: <u>Junction City, KS. 66441</u>	

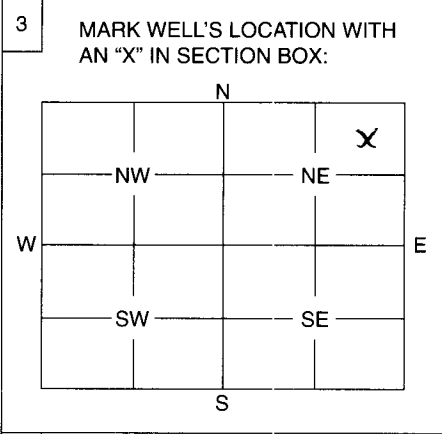

4	DEPTH OF WELL <u>250</u> ft.
	WELL'S STATIC WATER LEVEL <u>50</u> ft.
	WELL WAS USED AS:
	<input checked="" type="checkbox"/> 1 Domestic 5 Public Water Supply 9 Dewatering <input type="checkbox"/> 2 Irrigation 6 Oil Field Water Supply 10 Monitoring Well <input type="checkbox"/> 3 Feedlot 7 Domestic (Lawn & Garden) 11 Injection Well <input type="checkbox"/> 4 Industrial 8 Air Conditioning 12 Other
	Was a chemical / bacteriological sample submitted to Department? Yes No <input checked="" type="checkbox"/>
	If yes, mo/day/yr sample was submitted
	Water Well Disinfected: Yes <input checked="" type="checkbox"/> No

5	TYPE OF BLANK CASING USED:
	<input type="checkbox"/> 1 Steel <input type="checkbox"/> 3 RMP (SR) <input type="checkbox"/> 5 Wrought <input type="checkbox"/> 7 Fiberglass <input type="checkbox"/> 9 Other (Specify below) <input checked="" type="checkbox"/> 2 PVC <input type="checkbox"/> 4 ABS <input type="checkbox"/> 6 Asbestos-Cement <input type="checkbox"/> 8 Concrete Tile
	Blank casing diameter <u>5</u> in. Was casing pulled? Yes No <input checked="" type="checkbox"/>
	Casing height above or below land surface <u>48"</u> in. If yes, how much

6	GROUT PLUG MATERIAL: <input type="checkbox"/> 1 Neat cement <input checked="" type="checkbox"/> 2 Cement grout <input type="checkbox"/> 3 Bentonite <input type="checkbox"/> 4 Other
	Grout Plug Intervals: From <u>0</u> ft. to <u>250</u> ft., From ft. to ft., From to ft.
	What is the nearest source of possible contamination:
	<input checked="" type="checkbox"/> 1 Septic tank <input type="checkbox"/> 6 Seepage pit <input type="checkbox"/> 11 Fuel storage <input type="checkbox"/> 16 Other (specify below) <input type="checkbox"/> 2 Sewer lines <input type="checkbox"/> 7 Pit privy <input type="checkbox"/> 12 Fertilizer storage <input type="checkbox"/> 3 Watertight sewer lines <input type="checkbox"/> 8 Sewage lagoon <input type="checkbox"/> 13 Insecticide storage <input type="checkbox"/> 4 Lateral lines <input type="checkbox"/> 9 Feedyard <input type="checkbox"/> 14 Abandoned water well <input type="checkbox"/> 5 Cess pool <input type="checkbox"/> 10 Livestock pens <input type="checkbox"/> 15 Oil well/Gas well
	Direction from well? <u>EAST</u> How many feet? <u>300'</u>

FROM	TO	PLUGGING MATERIALS

7	CONTRACTOR'S OF LANDOWNER'S CERTIFICATION: This water well was plugged under my jurisdiction and was completed on (mo/day/year) <u>1/17/07</u> and this record is true to the best of my knowledge and belief. Kansas Water Well Contractor's License No. <u>NA</u> This Water Well Record was completed on (mo/day/year) <u>3-1-07</u> under the business name of <u>JTK Contracting, LLC</u> by (signature) <u>Thomas JTK</u>
---	---

INSTRUCTIONS: Use typewriter or ball point pen. Please press firmly and print clearly. Please fill in blanks, underline or circle the correct answers. Send top three copies to Kansas Department of Health and Environment, Bureau of Water, Geology Section, 1000 SW Jackson St., Ste. 420, Topeka, Kansas 66612-1367. Telephone: 785/296-5522. Send one to Water Well Owner and retain one for your records.