


1 LOCATION OF WATER WELL: Fraction NW ¼ NE ¼ NE ¼ Section Number 11 Township Number 12 S Range Number 5 E
 County: Geary

Distance and direction from nearest town or city street address of well if located within city?
539 W 6th Street, Junction City, KS

2 WATER WELL OWNER: Leiszler Oil Co. **Global Positioning System** (decimal degrees, min. of 4 digits)
 RR#, St. Address, Box #: 635 W. Crawford Latitude: 39°01'41.5"
 City, State, ZIP Code: Clay Center, KS Longitude: 96°50'19.8"
 Elevation: 1108.25 TOC
 Datum: Feet above mean sea level
 Data Collection Method: Legal survey

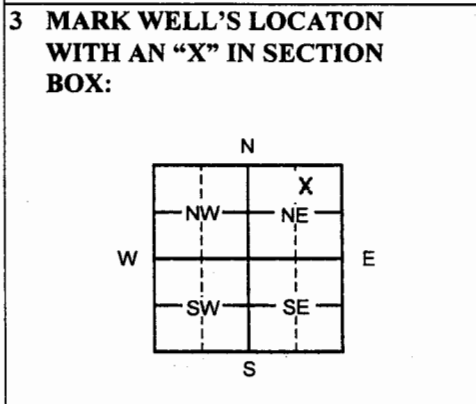

4 DEPTH OF WELL 49.3 ft. **MW8**
 WELL'S STATIC WATER LEVEL _____ ft.
 WELL WAS USED AS:
 1 Domestic | 5 Public Water Supply | 9 Dewatering
 2 Irrigation | 6 Oil Field Water Supply | 10 Monitoring
 3 Feedlot | 7 Domestic (Lawn & Garden) | 11 Injection Well
 4 Industrial | 8 Air Conditioning | 12 Other _____
 Was a chemical/bacteriological sample submitted to Department? Yes ___ No X

5 TYPE OF BLANK CASING USED:
 1 Steel | 3 RMP (SR) | 5 Wrought | 7 Fiberglass | 9 Other (specify below) _____
 2 PVC | 4 ABS | 6 Asbestos-Cement | 8 Concrete Tile
 Blank casing diameter _____ in. Was casing pulled? Yes X No ___ If yes, how much 3.0 feet
 Casing height above or below land surface 0 in.

6 GROUT PLUG MATERIAL: 1 Neat cement | 2 Cement grout | 3 Bentonite | 4 Other Soil, 0-3'
 Grout Plug Intervals: From 3 ft. to 49.3 ft., From _____ ft. to _____ ft., From _____ ft. to _____ ft.

What is the nearest source of possible contamination:
 1 Septic tank | 6 Seepage pit | 11 Fuel storage | 16 Other (specify below) _____
 2 Sewer lines | 7 Pit privy | 12 Fertilizer storage
 3 Watertight sewer lines | 8 Sewage lagoon | 13 Insecticide storage
 4 Lateral lines | 9 Feedyard | 14 Abandoned water well | Direction from well?
 5 Cess pool | 10 Livestock pens | 15 Oil well/Gas well | How many feet?

FROM	TO	PLUGGING MATERIALS	FROM	TO	PLUGGING MATERIALS
<u>0</u>	<u>3</u>	<u>Soil</u>			
<u>3</u>	<u>49.3</u>	<u>Bentonite</u>			

7 CONTRACTOR'S OR LANDOWNER'S CERTIFICATION: This water well was plugged under my jurisdiction and was completed on (mo/day/year) 5/5/08 and this record is true to the best of my knowledge and belief. Kansas Water Well Contractor's License No. 757. This Water Well Record was completed on (mo/day/year) 6/6/08 under the business name of Larsen and Associates, Inc. by (signature) _____

INSTRUCTIONS: Please fill in blanks or circle the correct answers. Send top three copies to Kansas Department of Health and Environment, Bureau of Water, Geology Section, 1000 SW Jackson St., Ste. 420, Topeka, Kansas 66612-1367. Telephone: 785/296-5522. Send one to Water Well Owner and retain one for your records. Visit us at <http://www.kdheks.gov/waterwell>.