


WATER WELL RECORD Form WWC-5

Original Record Correction Change in Well Use

Division of Water Resources App. No. Well ID

1 LOCATION OF WATER WELL: County: GARY Fraction NW 1/4 SW 1/4 Section Number 4 Township Number T 12 S Range Number R 5 E

2 WELL OWNER: Last Name: HUTON First: CONST Street or Rural Address where well is located (if unknown, distance and direction from nearest town or intersection): If at owner's address, check here:
 Business: HUTON CONST Address: 2229 SW. STACY City: WICHITA State: KS ZIP: 67213
K 18 + Munson Rd GARY CO.

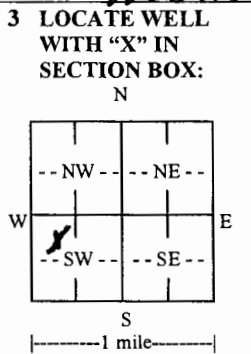

4 DEPTH OF COMPLETED WELL: 140' ft.
 Depth(s) Groundwater Encountered: 1) 9.3 ft.
 2) ft. 3) ft., or 4) Dry Well
 WELL'S STATIC WATER LEVEL: 55 ft. 7/2/2019
 below land surface, measured on (mo-day-yr)
 above land surface, measured on (mo-day-yr)
 Pump test data: Well water was ft. after hours pumping gpm
 Well water was ft. after hours pumping gpm
 Estimated Yield: 20 gpm
 Bore Hole Diameter: 7 1/8 in. to 150' ft. and in. to ft.

5 Latitude: N 39° 02.117 (decimal degrees)
Longitude: W 096° 53.277 (decimal degrees)
 Horizontal Datum: WGS 84 NAD 83 NAD 27
 Source for Latitude/Longitude: EMMIE TOPY 20
 GPS (unit make/model:)
 (WAAS enabled? Yes No)
 Land Survey Topographic Map
 Online Mapper:

6 Elevation: 1,215' ft. Ground Level TOC
 Source: Land Survey GPS Topographic Map
 Other

7 WELL WATER TO BE USED AS:

1. Domestic: Household Lawn & Garden Livestock Irrigation Feedlot Industrial

2. Public Water Supply: well ID
 3. Dewatering: how many wells?
 4. Aquifer Recharge: well ID
 5. Monitoring: well ID
 6. Environmental Remediation: well ID
 Air Sparge Soil Vapor Extraction Recovery Injection

7. Oil Field Water Supply: lease
 8. Test Hole: well ID
 Cased Uncased Geotechnical
 9. Geothermal: how many bores?
 a) Closed Loop Horizontal Vertical
 b) Open Loop Surface Discharge Inj. of Water
 10. Other (specify):

Was a chemical/bacteriological sample submitted to KDHE? Yes No If yes, date sample was submitted:

Water well disinfected? Yes No

8 TYPE OF CASING USED: Steel PVC Other CASING JOINTS: Glued Clamped Welded Threaded
 Casing diameter 5 1/2 in. to 10.5 ft., Diameter in. to ft., Diameter in. to ft.
 Casing height above land surface 31 in. Weight Sch. 40 lbs./ft. Wall thickness or gauge No.

TYPE OF SCREEN OR PERFORATION MATERIAL: Steel Stainless Steel Fiberglass PVC Other (Specify)
 Brass Galvanized Steel Concrete tile None used (open hole)

SCREEN OR PERFORATION OPENING ARE: Continuous Slot Mill Slot Gauze Wrapped Torch Cut Drilled Holes Other (Specify)
 Louvered Shutter Key Punched Wire Wrapped Saw Cut None (Open Hole)

SCREEN-PERFORATED INTERVALS: From 105 ft. to 145 ft., From ft. to ft., From ft. to ft.
 GRAVEL PACK INTERVALS: From ft. to ft., From ft. to ft., From ft. to ft.

9 GROUT MATERIAL: Neat cement Cement grout Bentonite Other
 Grout Intervals: From 5' ft. to 25' ft., From ft. to ft., From ft. to ft.

Nearest source of possible contamination: None Close

Septic Tank Lateral Lines Pit Privy Livestock Pens Insecticide Storage
 Sewer Lines Cess Pool Sewage Lagoon Fuel Storage Abandoned Water Well
 Watertight Sewer Lines Seepage Pit Feedyard Fertilizer Storage Oil Well/Gas Well
 Other (Specify)

Direction from well? Distance from well? ft.

10 FROM	TO	LITHOLOGIC LOG	FROM	TO	LITHO. LOG (cont.) or PLUGGING INTERVALS
0	25	Brown Clay	125	132	Limestone
25	28	Limestone	132	150	Glycol shale
28	37	Yellow shale			
37	44	Limestone			
44	78	Tan shale			
78	81	Limestone			
81	93	Glycol shale (Water)			
93	113	Limestone			
113	125	Brown shale			

11 CONTRACTOR'S OR LANDOWNER'S CERTIFICATION: This water well was constructed, reconstructed, or plugged under my jurisdiction and was completed on (mo-day-year) 7/2/2019 and this record is true to the best of my knowledge and belief. Kansas Water Well Contractor's License No. 451 This Water Well Record was completed on (mo-day-year) 7/26/2019 under the business name of HALDAMAN WELL DRILLING Gay, W. P.