


1 LOCATION OF WATER WELL: Fraction N.E. 1/4 N.W. 1/4 N.E. 1/4 Section Number 30 Township Number T 12 S Range Number R 5 E/W
 County: Geary

Distance and direction from nearest town or city street address of well if located within city?

2.5 miles west of U.S. 77 & I-70 and 1/2 mile south

2 WATER WELL OWNER: David Hildebrand
 RR#, St. Address, Box #: Rt. 3, Box 279A Board of Agriculture, Division of Water Resources
 City, State, ZIP Code: Junction City, Ks. 66441 Application Number: 41039

3 LOCATE WELL'S LOCATION WITH AN "X" IN SECTION BOX:

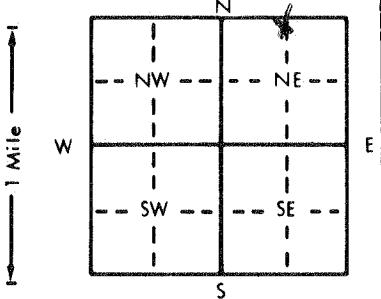

4 DEPTH OF COMPLETED WELL: 79 ft. ELEVATION:
 Depth(s) Groundwater Encountered 1. 27 ft. 2. ft. 3. ft.
 WELL'S STATIC WATER LEVEL: 27 ft. below land surface measured on mo/day/yr 10-28-94
 Pump test data: Well water was 45 ft. after 1 hours pumping 1100 gpm
 Est. Yield 2500 gpm: Well water was 51 ft. after 1 hours pumping 1500 gpm
 Bore Hole Diameter: 32 in. to 79 ft., and in. to ft.
 WELL WATER TO BE USED AS:
 5 Public water supply 8 Air conditioning 11 Injection well
 1 Domestic 3 Feedlot 6 Oil field water supply 9 Dewatering 12 Other (Specify below)
 2 Irrigation 4 Industrial 7 Lawn and garden only 10 Monitoring well
 Was a chemical/bacteriological sample submitted to Department? Yes.....NoXX.....; If yes, mo/day/yr sample was submitted
 Water Well Disinfected? Yes No XX

5 TYPE OF BLANK CASING USED:
 1 Steel 3 RMP (SR) 5 Wrought iron 8 Concrete tile CASING JOINTS: Glued XX, Clamped XX
 2 PVC 4 ABS 6 Asbestos-Cement 9 Other (specify below) Welded
 7 Fiberglass Threaded

Blank casing diameter: 16 in. to 59 ft., Dia in. to ft., Dia in. to ft.
 Casing height above land surface: 12 in., weight lbs./ft. Wall thickness or gauge No. 50

TYPE OF SCREEN OR PERFORATION MATERIAL:
 1 Steel 3 Stainless steel 5 Fiberglass 7 PVC 10 Asbestos-cement
 2 Brass 4 Galvanized steel 6 Concrete tile 8 RMP (SR) 11 Other (specify)
 9 ABS 12 None used (open hole)

SCREEN OR PERFORATION OPENINGS ARE:
 1 Continuous slot 3 Mill slot 5 Gauzed wrapped 8 Saw cut 11 None (open hole)
 2 Louvered shutter 4 Key punched 6 Wire wrapped 9 Drilled holes
 7 Torch cut 10 Other (specify)

SCREEN-PERFORATED INTERVALS: From 59 ft. to 79 ft., From ft. to ft.
 GRAVEL PACK INTERVALS: From 20 ft. to 59 ft., From ft. to ft.

6 GROUT MATERIAL: 1 Neat cement 2 Cement grout 3 Bentonite 4 Other
 Grout Intervals: From 0 ft. to 20 ft., From ft. to ft., From ft. to ft.

What is the nearest source of possible contamination:
 1 Septic tank 4 Lateral lines 7 Pit privy 10 Livestock pens 14 Abandoned water well
 2 Sewer lines 5 Cess pool 8 Sewage lagoon 11 Fuel storage 15 Oil well/Gas well
 3 Watertight sewer lines 6 Seepage pit 9 Feedyard 12 Fertilizer storage 16 Other (specify below)
 13 Insecticide storage none

Direction from well? How many feet?

FROM	TO	LITHOLOGIC LOG	FROM	TO	PLUGGING INTERVALS
0	1	Brown sand			
1	3	Black top soil			
3	32	Brown and black clays			
32	51	Small-medium brown gravel			
51	64	Small brown gravel			
64	79	Medium-large brown gravel			
	79	Yellow shale, stopped			

7 CONTRACTOR'S OR LANDOWNER'S CERTIFICATION: This water well was (1) constructed, (2) reconstructed, or (3) plugged under my jurisdiction and was completed on (mo/day/year) 10-29-94 and this record is true to the best of my knowledge and belief. Kansas Water Well Contractor's License No. 323 This Water Well Record was completed on (mo/day/yr) 11-21-94 under the business name of Hoobler Drilling Co. by (signature) [Signature]