


1 LOCATION OF WATER WELL: Fraction SW 1/4 NE 1/4 NW 1/4 Section Number 13 Township Number T 12 S Range Number R 5 EW
 County: Geary

Distance and direction from nearest town or city street address of well if located within city?
901 S. Washington Junction City, KS

2 WATER WELL OWNER: Robo car wash
 RR#, St. Address, Box #: 901 S. Washington Board of Agriculture, Division of Water Resources
 City, State, ZIP Code: Junction City, KS Application Number: —

3 LOCATE WELL'S LOCATION WITH AN "X" IN SECTION BOX:

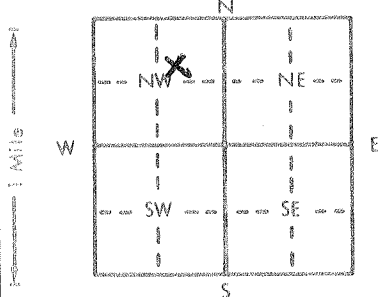

4 DEPTH OF COMPLETED WELL: 35 ft. ELEVATION: —
 Depth(s) Groundwater Encountered 1. 26.8 ft. 2. ~~—~~ ft. 3. — ft.
 WELL'S STATIC WATER LEVEL 28.98 ft. below land surface measured on mo/day/yr 11/3/94
 Pump test data: Well water was — ft. after — hours pumping — gpm
 Est. Yield — gpm: Well water was — ft. after — hours pumping — gpm
 Bore Hole Diameter 8.625 in. to 35 ft., and — in. to — ft.
 WELL WATER TO BE USED AS: 5 Public water supply 8 Air conditioning 11 Injection well
 1 Domestic 3 Feedlot 6 Oil field water supply 9 Dewatering 12 Other (Specify below)
 2 Irrigation 4 Industrial 7 Lawn and garden only 10 Monitoring well MW-1A
 Was a chemical/bacteriological sample submitted to Department? Yes — No X; If yes, mo/day/yr sample was submitted —
 Water Well Disinfected? Yes — No X

5 TYPE OF BLANK CASING USED: 5 Wrought iron 8 Concrete tile CASING JOINTS: Glued — Clamped —
 1 Steel 3 RMP (SR) 6 Asbestos-Cement 9 Other (specify below) Welded —
2 PVC 4 ABS 7 Fiberglass — Threaded X
 Blank casing diameter 2 in. to 20 ft., Dia — in. to — ft., Dia — in. to — ft.
 Casing height above land surface 0 in., weight Sch. 40 lbs./ft. Wall thickness or gauge No. —

TYPE OF SCREEN OR PERFORATION MATERIAL: 7 PVC 10 Asbestos-cement
 1 Steel 3 Stainless steel 5 Fiberglass 8 RMP (SR) 11 Other (specify) —
 2 Brass 4 Galvanized steel 6 Concrete tile 9 ABS 12 None used (open hole)

SCREEN OR PERFORATION OPENINGS ARE: 5 Gauzed wrapped 8 Saw cut 11 None (open hole)
 1 Continuous slot 3 Mill slot 6 Wire wrapped 9 Drilled holes
 2 Louvered shutter 4 Key punched 7 Torch cut 10 Other (specify) —

SCREEN-PERFORATED INTERVALS: From 20 ft. to 35 ft., From — ft. to — ft.
SAND From — ft. to — ft., From — ft. to — ft.
 GRAVEL PACK INTERVALS: From 19 ft. to 35 ft., From — ft. to — ft.
 From — ft. to — ft., From — ft. to — ft.

6 GROUT MATERIAL: 1 Neat cement 2 Cement grout 3 Bentonite 4 Other —
 Grout Intervals: From 0 ft. to 17 ft., From 17 ft. to 19 ft., From — ft. to — ft.

What is the nearest source of possible contamination: 10 Livestock pens 14 Abandoned water well
 1 Septic tank 4 Lateral lines 7 Pit privy 11 Fuel storage 15 Oil well/Gas well
 2 Sewer lines 5 Cess pool 8 Sewage lagoon 12 Fertilizer storage 16 Other (specify below)
 3 Watertight sewer lines 6 Seepage pit 9 Feedyard 13 Insecticide storage Contaminated site

Direction from well? How many feet?

FROM	TO	LITHOLOGIC LOG	FROM	TO	PLUGGING INTERVALS
0	0.5	Asphalt			
0.5	3.0	Clayey silt			
3.0	11.5	Silty clay			
11.5	14.0	clayey silt			
14.0	26.5	Silty clay			
26.5	35.0	Silty sand			
35.0	TD				

FLUSH MOUNT WAIVER
 OCT 17-94
 DON TAYLOR

7 CONTRACTOR'S OR LANDOWNER'S CERTIFICATION: This water well was (1) constructed, (2) reconstructed, or (3) plugged under my jurisdiction and was completed on (mo/day/year) 10-31-94 and this record is true to the best of my knowledge and belief. Kansas Water Well Contractor's License No. 479 This Water Well Record was completed on (mo/day/yr) 12-02-94 under the business name of EBBERTS DRILLING by (signature) Geoga Ebbert