


1 LOCATION OF WATER WELL: Fraction SW 1/4 NE 1/4 NW 1/4 Section Number 13 Township Number T 12 S Range Number R 5 E
 County: Geary

Distance and direction from nearest town or city street address of well if located within city?
901 S. Washington, Junction City, Kansas

2 WATER WELL OWNER: Robo Car Wash
 RR#, St. Address, Box #: 901 S. Washington
 City, State, ZIP Code: Junction City, ks
 Board of Agriculture, Division of Water Resources
 Application Number: ---

3 LOCATE WELL'S LOCATION WITH AN "X" IN SECTION BOX:

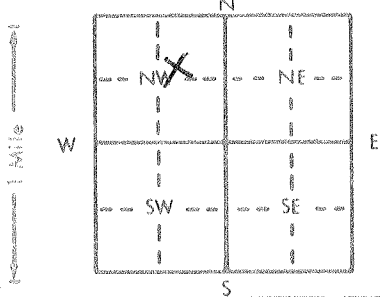

4 DEPTH OF COMPLETED WELL: 35 ft. ELEVATION: ---

Depth(s) Groundwater Encountered 1. 27.90 ft. 2. --- ft. 3. --- ft.
 WELL'S STATIC WATER LEVEL 30.27 ft. below land surface measured on mo/day/yr 11-3-94
 Pump test data: Well water was --- ft. after --- hours pumping --- gpm
 Est. Yield --- gpm: Well water was --- ft. after --- hours pumping --- gpm
 Bore Hole Diameter 8.625 in. to 35 ft., and --- in. to --- ft.
 WELL WATER TO BE USED AS: 5 Public water supply 8 Air conditioning 11 Injection well
 1 Domestic 3 Feedlot 6 Oil field water supply 9 Dewatering 12 Other (Specify below)
 2 Irrigation 4 Industrial 7 Lawn and garden only 10 Monitoring well MW-2A
 Was a chemical/bacteriological sample submitted to Department? Yes --- No X; If yes, mo/day/yr sample was submitted ---
 Water Well Disinfected? Yes --- No X

5 TYPE OF BLANK CASING USED: 5 Wrought iron 8 Concrete tile CASING JOINTS: Glued --- Clamped ---
 1 Steel 3 RMP (SR) 6 Asbestos-Cement 9 Other (specify below) Welded ---
2 PVC 4 ABS 7 Fiberglass --- Threaded X

Blank casing diameter 2 in. to 20 ft., Dia. --- in. to --- ft., Dia. --- in. to --- ft.
 Casing height above land surface 24 in., weight Sch. 40 lbs./ft. Wall thickness or gauge No. ---

TYPE OF SCREEN OR PERFORATION MATERIAL: 7 PVC 10 Asbestos-cement
 1 Steel 3 Stainless steel 5 Fiberglass 8 RMP (SR) 11 Other (specify) ---
 2 Brass 4 Galvanized steel 6 Concrete tile 9 ABS 12 None used (open hole)

SCREEN OR PERFORATION OPENINGS ARE: 5 Gauzed wrapped 8 Saw cut 11 None (open hole)
 1 Continuous slot 3 Mill slot 6 Wire wrapped 9 Drilled holes
 2 Louvered shutter 4 Key punched 7 Torch cut 10 Other (specify) ---

SCREEN-PERFORATED INTERVALS: From 20 ft. to 35 ft., From --- ft. to --- ft.
 From --- ft. to --- ft., From --- ft. to --- ft.
 SAND GRAVEL PACK INTERVALS: From 19 ft. to 35 ft., From --- ft. to --- ft.
 From --- ft. to --- ft., From --- ft. to --- ft.

6 GROUT MATERIAL: 2 1 Neat cement 2 Cement grout 3 Bentonite 4 Other ---
 Grout Intervals: From 0 ft. to 17 ft., From 17 ft. to 19 ft., From --- ft. to --- ft.

What is the nearest source of possible contamination: 10 Livestock pens 14 Abandoned water well
 1 Septic tank 4 Lateral lines 7 Pit privy 11 Fuel storage 15 Oil well/Gas well
 2 Sewer lines 5 Cess pool 8 Sewage lagoon 12 Fertilizer storage 16 Other (specify below)
 3 Watertight sewer lines 6 Seepage pit 9 Feedyard 13 Insecticide storage Contaminated site
 Direction from well? How many feet? ---

FROM	TO	LITHOLOGIC LOG	FROM	TO	PLUGGING INTERVALS
0	0.5	Fill, soil			
0.5	4.5	clayey silt			
4.5	9.0	silty clay			
9.0	16.0	clayey silt			
16.0	24.5	silty clay			
24.5	35.0	SAND			
35.0	TD				

7 CONTRACTOR'S OR LANDOWNER'S CERTIFICATION: This water well was (1) constructed (2) reconstructed, or (3) plugged under my jurisdiction and was completed on (mo/day/year) 11-1-94 and this record is true to the best of my knowledge and belief. Kansa Water Well Contractor's License No. 779 This Water Well Record was completed on (mo/day/yr) 12-02-94 under the business name of EBBERTS DRILLING by (signature) Angela Ebbert