


1 LOCATION OF WATER WELL: County: GARY CO. Fraction: NE 1/4 NE 1/4 NE 1/4 Section Number: 8 Township Number: T 12 S Range Number: R 6 E

Distance and direction from nearest town or city street address of well if located within city? From Junction City Mo 2 miles East on E 70

2 WATER WELL OWNER: Harold Glessner
 RR#, St. Address, Box #: 715 Glessner Lane
 City, State, ZIP Code: Junction City, Mo 66441
 Board of Agriculture, Division of Water Resource Application Number:

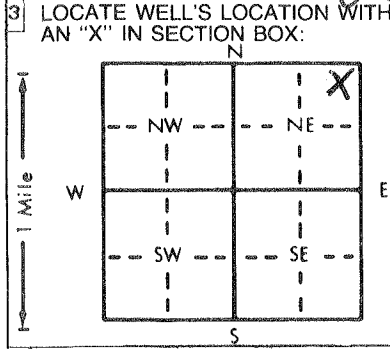

4 DEPTH OF COMPLETED WELL: 160 ft. ELEVATION:
 Depth(s) Groundwater Encountered: 1, 121 ft. 2, ft. 3, ft.
 WELL'S STATIC WATER LEVEL: 121 ft. below land surface measured on mo/day/yr
 Pump test data: Well water was ft. after hours pumping gpm
 Est. Yield: 15 gpm; Well water was ft. after hours pumping gpm
 Bore Hole Diameter: 9 in. to 160 ft., and in. to ft.
 WELL WATER TO BE USED AS:
 1 Domestic 3 Feedlot 6 Oil field water supply 9 Dewatering 12 Other (Specify below)
 2 Irrigation 4 Industrial 7 Lawn and garden only 10 Monitoring well
 Was a chemical/bacteriological sample submitted to Department? Yes.....No.....; If yes, mo/day/yr sample was submitted
 Water Well Disinfected? Yes No

5 TYPE OF BLANK CASING USED:
 1 Steel 3 RMP (SR) 6 Asbestos-Cement 9 Other (specify below)
 2 PVC 4 ABS 7 Fiberglass
 Blank casing diameter: 5 in. to 140 ft., Dia in. to ft., Dia in. to ft.
 Casing height above land surface: 2 in., weight 5040 lbs./ft. Wall thickness or gauge No.
 TYPE OF SCREEN OR PERFORATION MATERIAL:
 1 Steel 3 Stainless steel 5 Fiberglass 7 PVC 10 Asbestos-cement
 2 Brass 4 Galvanized steel 6 Concrete tile 8 RMP (SR) 11 Other (specify)
 3 Mill slot 5 Gauzed wrapped 8 Saw cut 11 None (open hole)
 1 Continuous slot 6 Wire wrapped 9 Drilled holes
 2 Louvered shutter 7 Torch cut 10 Other (specify)
 SCREEN OR PERFORATION OPENINGS ARE:
 SCREEN-PERFORATED INTERVALS: From 140 ft. to 160 ft., From ft. to ft.
 GRAVEL PACK INTERVALS: From 25 ft. to 160 ft., From ft. to ft.

6 GROUT MATERIAL: 1 Neat cement 2 Cement grout 3 Bentonite 4 Other
 Grout Intervals: From 0 ft. to 25 ft., From ft. to ft., From ft. to ft.
 What is the nearest source of possible contamination:
 1 Septic tank 4 Lateral lines 7 Pit privy 10 Livestock pens 14 Abandoned water well
 2 Sewer lines 5 Cess pool 8 Sewage lagoon 11 Fuel storage 15 Oil well/Gas well
 3 Watertight sewer lines 6 Seepage pit 9 Feedyard 12 Fertilizer storage 16 Other (specify below)
 13 Insecticide storage
 Direction from well? East How many feet? 150

FROM	TO	LITHOLOGIC LOG	FROM	TO	PLUGGING INTERVALS
0	6	Top Soil			
6	8	Brown Clay			
8	12	Limestone			
12	31	Yellow Shale			
31	34	Greenish Shale			
34	34	Limestone			
34	45	Greenish Shale			
45	44	Brown Shale			
44	96	Limestone			
96	121	Brown Shale			
121	134	Limestone (water)			
134	138	Brown Shale			
138	144	Limestone			
144	155	Grey Shale			
155	160	Limestone			

7 CONTRACTOR'S OR LANDOWNER'S CERTIFICATION: This water well was (1) constructed, (2) reconstructed, or (3) plugged under my jurisdiction and was completed on (mo/day/year) 6/14/96 and this record is true to the best of my knowledge and belief. Kansas Water Well Contractor's License No. 451 This Water Well Record was completed on (mo/day/yr) 6/17/96 under the business name of Holdeman Well Drilling by (signature) Arnie H. Holdeman

INSTRUCTIONS: Use typewriter or ball point pen. PLEASE PRESS FIRMLY and PRINT clearly. Please fill in blanks, underline or circle the correct answers. Send top three copies to Kansas Department of Health and Environment, Bureau of Water, Topeka, Kansas 66620-0001. Telephone: 913-296-5545. Send one to WATER WELL OWNER and retain one for your records.