


1] LOCATION OF WATER WELL: Fraction NE 1/4 SE 1/4 NW 1/4 Section Number 1 Township Number T 12 S Range Number R 06 E
 County: GEARY
 Distance and direction from nearest town or city street address of well if located within city? From GRANVIEW PLAZA 60 S MILES EAST ON I-70 TO HUMBOLT ROAD + 1 1/2 MILES SOUTH ON HUMBOLT + 1/4 NORTH EAST

2] WATER WELL OWNER: TODD STRAIN
 RR#, St. Address, Box #: RR # 2 Box 70 Board of Agriculture, Division of Water Resource
 City, State, ZIP Code: JUNCTION CITY KS 66644 Application Number:

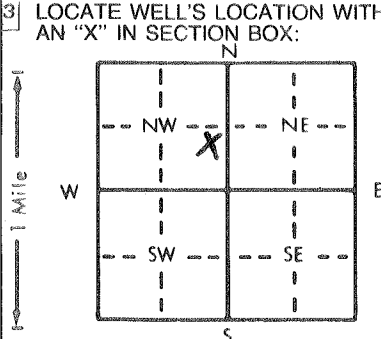

4] DEPTH OF COMPLETED WELL: 100 ft. ELEVATION:
 Depth(s) Groundwater Encountered 1. 81 ft. 2. ft. 3. ft.
 WELL'S STATIC WATER LEVEL: 198 ft. below land surface measured on mo/day/yr
 Pump test data: Well water was ft. after hours pumping gpm
 Est. Yield: 15 gpm: Well water was ft. after hours pumping gpm
 Bore Hole Diameter: 9 in. to 100 ft., and in. to ft.
 WELL WATER TO BE USED AS:
 Domestic 3 Feedlot 6 Oil field water supply 9 Dewatering 12 Other (Specify below)
 2 Irrigation 4 Industrial 7 Lawn and garden only 10 Monitoring well
 Was a chemical/bacteriological sample submitted to Department? Yes.....No.....; If yes, mo/day/yr sample was submitted

5] TYPE OF BLANK CASING USED:
 1 Steel 3 RMP (SR) 5 Wrought iron 8 Concrete tile CASING JOINTS: Glued Screewed Clamped
 2 PVC 4 ABS 6 Asbestos-Cement 9 Other (specify below) Welded
 7 Fiberglass Threaded
 Blank casing diameter: 5 in. to 80 ft., Dia. in. to ft., Dia. in. to ft.
 Casing height above land surface: 2 in., weight: SLH. 40 lbs./ft. Wall thickness or gauge No.
 TYPE OF SCREEN OR PERFORATION MATERIAL:
 1 Steel 3 Stainless steel 5 Fiberglass 8 RMP (SR) 10 Asbestos-cement
 2 Brass 4 Galvanized steel 6 Concrete tile 9 ABS 12 None used (open hole)
 SCREEN OR PERFORATION OPENINGS ARE:
 1 Continuous slot 3 Mill slot 3 1/1000's 5 Gauzed wrapped 8 Saw cut 11 None (open hole)
 2 Louvered shutter 4 Key punched 6 Wire wrapped 9 Drilled holes
 7 Torch cut 10 Other (specify)
 SCREEN-PERFORATED INTERVALS: From 80 ft. to 100 ft., From ft. to ft.
 GRAVEL PACK INTERVALS: From 20 ft. to 100 ft., From ft. to ft.

6] GROUT MATERIAL: 1 Neat cement 2 Cement grout 3 Bentonite 4 Other
 Grout Intervals: From 0 ft. to 20 ft., From ft. to ft. ENVIRONMENTAL
 What is the nearest source of possible contamination:
 1 Septic tank 4 Lateral lines 7 Pit privy 10 Livestock pens 14 Abandoned water well
 2 Sewer lines 5 Cess pool 8 Sewage lagoon 11 Fuel storage 15 Oil well/Gas well
 3 Watertight sewer lines 6 Seepage pit 9 Feedyard 12 Fertilizer storage 16 Other (specify below)
 Direction from well? SOUTH WEST How many feet? 300'

FROM	TO	LITHOLOGIC LOG	FROM	TO	PLUGGING INTERVALS
0	1 1/2	TOP SOIL	58	71	LIMESTONE
1 1/2	12	YELLOW SHALE	71	72	BROWN SHALE
12	14	FLINT ROCK	72	75	LIMESTONE
14	22	BROWN SHALE	75	81	GRAY SHALE
22	23	LIMESTONE	81	85	LIME STONE
23	26	BROWN SHALE	85	95	BROWN SHALE
26	29	YELLOW SHALE	95	100	LIME STONE
29	34	BROWN SHALE			
34	36	GRAYISH SHALE LIMESTONE			
36	38	GRAYISH SHALE			
38	42	LIMESTONE			
42	48	GRAYISH SHALE			
48	53	GRAY SHALE			
53	57	LIMESTONE			
57	58	BROWN SHALE			

7] CONTRACTOR'S OR LANDOWNER'S CERTIFICATION: This water well was constructed, reconstructed, or plugged under my jurisdiction and was completed on (mo/day/year) 9/18/90 and this record is true to the best of my knowledge and belief. Kansas Water Well Contractor's License No. 451 This Water Well Record was completed on (mo/day/yr) 10/22/90 under the business name of HALDAMAN WELL DRILLING by (signature) [Signature]