


1 LOCATION OF WATER WELL: County: Geary Fraction: NW 1/4 SE 1/4 SE 1/4 Section Number: 4 Township Number: T 12 S Range Number: R 6 E/W

Distance and direction from nearest town or city street address of well if located within city?
1 1/2 mile East of Grandview Plaza

2 WATER WELL OWNER: Norman Lee
 RR#, St. Address, Box #: Rt 2 Box 13
 City, State, ZIP Code: Junction City, Ks 66441
 Board of Agriculture, Division of Water Resources
 Application Number:

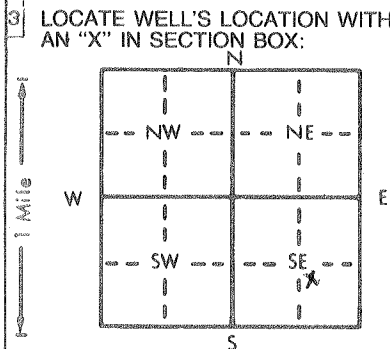

4 DEPTH OF COMPLETED WELL: 125 ft. ELEVATION: _____
 Depth(s) Groundwater Encountered 1. 105 ft. 2. _____ ft. 3. _____ ft.
 WELL'S STATIC WATER LEVEL: 78 ft. below land surface measured on mo/day/yr Feb 5 90
 Pump test data: Well water was _____ ft. after _____ hours pumping _____ gpm
 Est. Yield: 10 gpm. Well water was _____ ft. after _____ hours pumping _____ gpm
 Bore Hole Diameter: 8 in. to 40 ft., and 6 7/8 in. to 125 ft.
 WELL WATER TO BE USED AS:
 1 Domestic 3 Feedlot 6 Oil field water supply 9 Dewatering 12 Other (Specify below)
 2 Irrigation 4 Industrial 7 Lawn and garden only 10 Monitoring well
 Was a chemical/bacteriological sample submitted to Department? Yes _____ No X _____ If yes, mo/day/yr sample was submitted _____
 Water Well Disinfected? Yes No

5 TYPE OF BLANK CASING USED:
 1 Steel 3 RMP (SR) 6 Asbestos-Cement 9 Other (specify below) CASING JOINTS: Glued X Clamped _____
 2 PVC 4 ABS 7 Fiberglass _____ _____
 Blank casing diameter: 5 in. to 85 ft., Dia. _____ in. to _____ ft., Dia. _____ in. to _____ ft.
 Casing height above land surface: 16 in., weight _____ lbs./ft. Wall thickness or gauge No. SPR-26
 TYPE OF SCREEN OR PERFORATION MATERIAL:
 1 Steel 3 Stainless steel 5 Fiberglass 7 PVC 10 Asbestos-cement
 2 Brass 4 Galvanized steel 6 Concrete tile 8 RMP (SR) 11 Other (specify) _____
 12 None used (open hole)
 SCREEN OR PERFORATION OPENINGS ARE:
 1 Continuous slot 3 Mill slot 5 Gauzed wrapped 6 Saw cut 11 None (open hole)
 2 Louvered shutter 4 Key punched 6 Wire wrapped 9 Drilled holes
 7 Torch cut 10 Other (specify) _____
 SCREEN-PERFORATED INTERVALS: From 85 ft. to 125 ft., From _____ ft. to _____ ft.
 From _____ ft. to _____ ft., From _____ ft. to _____ ft.
 GRAVEL PACK INTERVALS: From NONE ft. to _____ ft., From _____ ft. to _____ ft.
 From _____ ft. to _____ ft., From _____ ft. to _____ ft.

6 GROUT MATERIAL: 1 Neat cement 2 Cement grout 3 Bentonite 4 Other _____
 Grout Intervals: From 3 ft. to 40 ft., From _____ ft. to _____ ft., From _____ ft. to _____ ft.
 What is the nearest source of possible contamination:
 1 Septic tank 4 Lateral lines 7 Pit privy 10 Livestock pens 14 Abandoned water well
 2 Sewer lines 5 Cess pool 8 Sewage lagoon 11 Fuel storage 15 Oil well/Gas well
 3 Watertight sewer lines 6 Seepage pit 9 Feedyard 12 Fertilizer storage 16 Other (specify below)
 13 Insecticide storage
 Direction from well? North West How many feet? 125

| FROM | TO | LITHOLOGIC LOG | FROM | TO | PLUGGING INTERVALS |
|------|----|-------------------------------|------|-----|---------------------------|
| 0 | 14 | Clay Red | 87 | 90 | LIME - TAN |
| 14 | 25 | LIME Lite / Flint Blw | 90 | 96 | LIME - Crumbly TAN |
| 25 | 30 | Shale Lite Gray | 96 | 105 | Red Rock - Extremely Soft |
| 30 | 37 | Red Rock | 105 | 110 | LIME - TAN / Flint |
| 37 | 40 | LIME TAN | 110 | 112 | Shale Gray |
| 40 | 49 | Shale Green | 112 | 117 | LIME - TAN |
| 49 | 53 | LIME Lite - Crumbly | 117 | 121 | Shale Dark Gray |
| 53 | 60 | LIME & Gray Shale - Soft | 121 | 125 | LIME TAN / Flint |
| 60 | 62 | LIME Gray Solid | | | |
| 62 | 64 | Shale Gray | | | |
| 64 | 70 | LIME Lite - Some Fractures | | | |
| 70 | 72 | LIME Lite - Solid | | | |
| 72 | 77 | Frac LIME & Shale - Yellowish | | | |
| 77 | 80 | LIME - TAN | | | |
| 80 | 87 | Shale - DK Gray | | | |

7 CONTRACTOR'S OR LANDOWNER'S CERTIFICATION: This water well was (1) constructed, (2) reconstructed, or (3) plugged under my jurisdiction and was completed on (mo/day/year) Feb 5 90 and this record is true to the best of my knowledge and belief. Kansas Water Well Contractor's License No. 218 This Water Well Record was completed on (mo/day/yr) Feb 25 90 under the business name of ZINN Water Well Drlg by (signature) Joseph A. Zinn

INSTRUCTIONS: Use typewriter or ball point pen. PLEASE PRESS FIRMLY and PRINT clearly. Please fill in blanks, underline or circle the correct answers. Send top three copies to Kansas Department of Health and Environment, Bureau of Water Protection, Topeka, Kansas 66620-7320. Telephone: 913-296-5514. Send one to WATER WELL OWNER and retain one for your records.

LO100000000-00