


LOCATION OF WATER WELL: Fraction SE 1/4 NW 1/4 SE 1/4 Section Number 9 Township Number T 12 S Range Number R 6 E

County: Geary Distance and direction from nearest town or city street address of well if located within city? 1 E of Grandview Plaza at Junction City

WATER WELL OWNER: Row Stopher Board of Agriculture, Division of Water Resources  
 RR#, St. Address, Box #: 1203 W. 6th Application Number:  
 City, State, ZIP Code: Junction City 66441

LOCATE WELL'S LOCATION WITH AN "X" IN SECTION BOX:

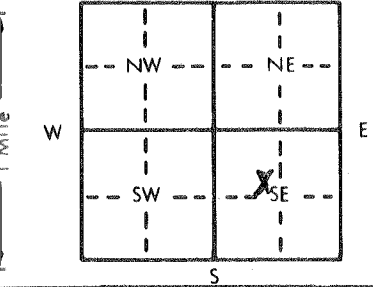

DEPTH OF COMPLETED WELL: 140 ft. ELEVATION: ..... ft.  
 Depth(s) Groundwater Encountered 1. 58 ft. 2. .... ft. 3. .... ft.  
 WELL'S STATIC WATER LEVEL: 90 ft. below land surface measured on mo/day/yr 6-22-83  
 Pump test data: Well water was ..... ft. after ..... hours pumping ..... gpm  
 Est. Yield 20 gpm; Well water was ..... ft. after ..... hours pumping ..... gpm  
 Bore Hole Diameter: 8 in. to 140 ft., and ..... in. to ..... ft.  
 WELL WATER TO BE USED AS:  
 1 Domestic 3 Feedlot 6 Oil field water supply 9 Dewatering 12 Other (Specify below)  
 2 Irrigation 4 Industrial 7 Lawn and garden only 10 Observation well  
 Was a chemical/bacteriological sample submitted to Department? Yes No; If yes, mo/day/yr sample was submitted  
 Water Well Disinfected? Yes No

TYPE OF BLANK CASING USED:  
 1 Steel 3 RMP (SR) 5 Wrought iron 8 Concrete tile CASING JOINTS: Glued W Clamped .....  
 2 PVC 4 ABS 6 Asbestos-Cement 9 Other (specify below) Welded .....  
 7 Fiberglass Threaded .....  
 Blank casing diameter 5 in. to 0-50 ft., Dia 5 in. to 70-115 ft., Dia 5 in. to 125-140 ft.  
 Casing height above land surface: 24 in., weight 287 lbs./ft. Wall thickness or gauge No. 258

TYPE OF SCREEN OR PERFORATION MATERIAL:  
 1 Steel 3 Stainless steel 5 Fiberglass 7 PVC 10 Asbestos-cement  
 2 Brass 4 Galvanized steel 6 Concrete tile 8 RMP (SR) 11 Other (specify) .....  
 9 ABS 12 None used (open hole)

SCREEN OR PERFORATION OPENINGS ARE:  
 1 Continuous slot 3 Mill slot 5 Gauzed wrapped 8 Saw cut 11 None (open hole)  
 2 Louvered shutter 4 Key punched 6 Wire wrapped 9 Drilled holes  
 7 Torch cut 10 Other (specify) .....

SCREEN-PERFORATED INTERVALS: From 50 ft. to 70 ft., From ..... ft. to ..... ft.  
 From 115 ft. to 125 ft., From ..... ft. to ..... ft.  
 GRAVEL PACK INTERVALS: From 10 ft. to 140 ft., From ..... ft. to ..... ft.  
 From ..... ft. to ..... ft., From ..... ft. to ..... ft.

GROUT MATERIAL: 1 Neat cement 2 Cement grout 3 Bentonite 4 Other .....  
 Grout Intervals: From 0 ft. to 10 ft., From ..... ft. to ..... ft., From ..... ft. to ..... ft.

What is the nearest source of possible contamination:  
 1 Septic tank 4 Lateral lines 7 Pit privy 10 Livestock pens 14 Abandoned water well  
 2 Sewer lines 5 Cess pool 8 Sewage lagoon 11 Fuel storage 15 Oil well/Gas well  
 3 Watertight sewer lines 6 Seepage pit 9 Feedyard 12 Fertilizer storage 16 Other (specify below)  
 13 Insecticide storage .....

Direction from well? E How many feet? 160

FROM	TO	LITHOLOGIC LOG	FROM	TO	LITHOLOGIC LOG
0	3	Top soil			
3	44	Clay brown			
44	58	Shale yellow			
58	61	LS, yellow			
61	69	shale yellow			
69	73	LS grey			
73	99	Shale grey			
99	110	shale yellow			
110	118	shale red			
118	121	LS yellow			
121	139	Shale grey			
139	140	LS grey			

CONTRACTOR'S OR LANDOWNER'S CERTIFICATION: This water well was (1) constructed, (2) reconstructed, or (3) plugged under my jurisdiction and was completed on (mo/day/year) 5-22-83 and this record is true to the best of my knowledge and belief. Kansas Water Well Contractor's License No. 182 This Water Well Record was completed on (mo/day/yr) 7-14-83 under the business name of Strader Drlg Co. Inc by (signature) Dale Roberson

INSTRUCTIONS: Use typewriter or ball point pen, PLEASE PRESS FIRMLY and PRINT clearly. Please fill in blanks, underline or circle the correct answers. Send top three copies to Kansas Department of Health and Environment, Division of Environment, Environmental Geology Section, Topeka, KS 66620. Send one to WATER WELL OWNER and retain one for your records.