


1 LOCATION OF WATER WELL: County: CREARY Fraction: $\frac{1}{4}$ NE $\frac{1}{4}$ SW $\frac{1}{4}$ Section Number: OS Township Number: T 12 S Range Number: R 06 EW

Distance and direction from nearest town or city street address of well if located within city?
Located on City Easement at 510 Grandview Drive

2 WATER WELL OWNER: KDNE - GPI
 RR#, St. Address, Box # : Topeka, Ks 66620
 City, State, ZIP Code : Topeka, Ks 66620
 Board of Agriculture, Division of Water Resource
 Application Number:

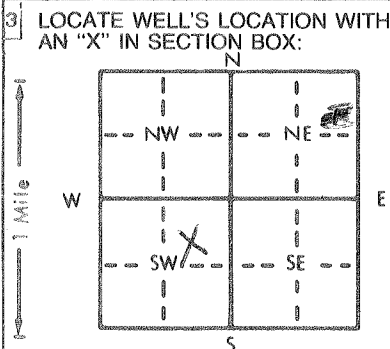

4 DEPTH OF COMPLETED WELL: 91.45 ft. ELEVATION:
 Depth(s) Groundwater Encountered 1. 62.45 ft. 2. ft. 3. ft.
 WELL'S STATIC WATER LEVEL: 61.98 ft. below land surface measured on 5/10/88
 Pump test data: Well water was ft. after hours pumping gpm
 Est. Yield gpm; Well water was ft. after hours pumping gpm
 Bore Hole Diameter: 7 7/8 in. to ft., and in. to ft.
 WELL WATER TO BE USED AS: 5 Public water supply 8 Air conditioning 11 Injection well
 1 Domestic 3 Feedlot 6 Oil field water supply 9 Dewatering 12 Other (Specify below)
 2 Irrigation 4 Industrial 7 Lawn and garden only 10 Monitoring well Monitoring
 Was a chemical/bacteriological sample submitted to Department? Yes. No. ; if yes, mo/day/yr sample was submitted 5/12/88
 Water Well Disinfected? Yes No

5 TYPE OF BLANK CASING USED: 1 Steel 3 RMP (SR) 5 Wrought iron 8 Concrete tile CASING JOINTS: Glued Clamped
2 PVC 4 ABS 7 Fiberglass 9 Other (specify below) Welded
 Blank casing diameter: 2 in. to 91.45 ft., Dia. in. to ft., Dia. in. to ft.
 Casing height above land surface: in., weight lbs./ft. Wall thickness or gauge No.
 TYPE OF SCREEN OR PERFORATION MATERIAL: 7 PVC 10 Asbestos-cement
 1 Steel 3 Stainless steel 5 Fiberglass 8 RMP (SR) 11 Other (specify)
 2 Brass 4 Galvanized steel 6 Concrete tile 9 ABS 12 None used (open hole)

SCREEN OR PERFORATION OPENINGS ARE: 5 Gauzed wrapped 8 Saw cut 11 None (open hole)
 1 Continuous slot 3 Mill slot 6 Wire wrapped 9 Drilled holes
 2 Louvered shutter 4 Key punched 7 Torch cut 10 Other (specify)
 SCREEN-PERFORATED INTERVALS: From 81.45 ft. to 91.45 ft., From ft. to ft.
 GRAVEL PACK INTERVALS: From 22 ft. to 91.45 ft., From ft. to ft.
 From ft. to ft., From ft. to ft.

6 GROUT MATERIAL: 1 Neat cement 2 Cement grout 3 Bentonite 4 Other
 Grout Intervals: From 0 ft. to 20 ft., From 20 ft. to 22 ft., From ft. to ft.
 What is the nearest source of possible contamination:
 1 Septic tank 4 Lateral lines 7 Pit privy 10 Livestock pens 14 Abandoned water well
 2 Sewer lines 5 Cess pool 8 Sewage lagoon 11 Fuel storage 15 Oil well/Gas well
 3 Watertight sewer lines 6 Seepage pit 9 Feedyard 12 Fertilizer storage 16 Other (specify below)
 Direction from well? How many feet? ~400 ft EAST
Contaminated PWS wells

FROM	TO	LITHOLOGIC LOG	FROM	TO	PLUGGING INTERVALS
0	5	TOPSOIL			
5	15	Brown Silty Clay			
15	65	Reddish Silt with Cherty Limestone			
65	80	Red Brown fine Sands with Cherty Limestone			
80	88	Brown Sand with Cherty Limestone			
88	91	Blue Gray Shale			

7 CONTRACTOR'S OR LANDOWNER'S CERTIFICATION: This water well was (1) constructed, (2) reconstructed, or (3) plugged under my jurisdiction and was completed on (mo/day/year) 5/12/88 and this record is true to the best of my knowledge and belief. Kansas Water Well Contractor's License No. KDNE This Water Well Record was completed on (mo/day/yr) 5/21/88 under the business name of KDNE by (signature) [Signature]