


1 LOCATION OF WATER WELL: County: Oreary Fraction: NW 1/4 SW 1/4 SW 1/4 Section Number: 6 Township Number: T 12 S Range Number: R 6 E/W

Distance and direction from nearest town or city street address of well if located within city?

903 N Filley

2 WATER WELL OWNER: Golda Webster
 RR#, St. Address, Box #: 903 N Filley Board of Agriculture, Division of Water Resources
 City, State, ZIP Code: Junction City Ks. Application Number:

3 LOCATE WELL'S LOCATION WITH AN "X" IN SECTION BOX:

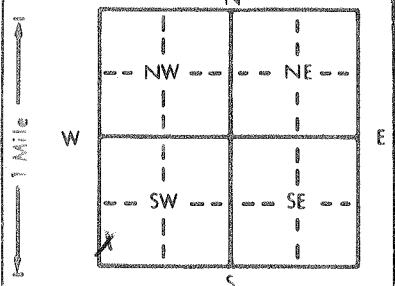

4 DEPTH OF COMPLETED WELL: 54 ft. ELEVATION: _____
 Depth(s) Groundwater Encountered 1. _____ ft. 2. _____ ft. 3. _____ ft.
 WELL'S STATIC WATER LEVEL: 74 ft. below land surface measured on mo/day/yr Aug. 16. 88.
 Pump test data: Well water was _____ ft. after _____ hours pumping _____ gpm
 Est. Yield: 30 gpm: Well water was _____ ft. after _____ hours pumping _____ gpm
 Bore Hole Diameter: 9.11 in. to 54 ft., and _____ in. to _____ ft.
 WELL WATER TO BE USED AS:
 1 Domestic 3 Feedlot 6 Oil field water supply 9 Dewatering 12 Other (Specify below)
 2 Irrigation 4 Industrial X 7 Lawn and garden only 10 Monitoring well
 Was a chemical/bacteriological sample submitted to Department? Yes _____ No ✓; If yes, mo/day/yr sample was submitted _____
 Water Well Disinfected? Yes ✓ No _____

5 TYPE OF CASING USED:
 1 Steel 3 RMP (SR) 5 Wrought iron 8 Concrete tile CASING JOINTS: Glued ✓ Clamped _____
X 2 PVC 4 ABS 7 Fiberglass 9 Other (specify below) Welded _____
 Blank casing diameter: 5.1 in. to 94 ft., Dia _____ in. to _____ ft., Dia _____ in. to _____ ft.
 Casing height above land surface: 24 in., weight 200 lbs./ft. Wall thickness or gauge No. _____

TYPE OF SCREEN OR PERFORATION MATERIAL:
 1 Steel 3 Stainless steel 5 Fiberglass 8 RMP (SR) 10 Asbestos-cement
 2 Brass 4 Galvanized steel 6 Concrete tile 9 ABS 11 Other (specify) _____
 SCREEN OR PERFORATION OPENINGS ARE:
 1 Continuous slot 3 Mill slot 5 Gauzed wrapped X 8 Saw cut 11 None (open hole)
 2 Louvered shutter 4 Key punched 6 Wire wrapped 9 Drilled holes
 7 Torch cut 10 Other (specify) _____

SCREEN-PERFORATED INTERVALS: From: 14 ft. to 54 ft., From _____ ft. to _____ ft.
 From: _____ ft. to _____ ft., From _____ ft. to _____ ft.
 GRAVEL PACK INTERVALS: From: 70 ft. to 54 ft., From _____ ft. to _____ ft.
 From: _____ ft. to _____ ft., From _____ ft. to _____ ft.

6 GROUT MATERIAL: 1 Neat cement 2 Cement grout X 3 Bentonite 4 Other _____
 Grout Intervals: From: 0 ft. to 90 ft., From _____ ft. to _____ ft., From _____ ft. to _____ ft.

What is the nearest source of possible contamination:
 1 Septic tank 4 Lateral lines 7 Pit privy 10 Livestock pens 14 Abandoned water well
X 2 Sewer lines 5 Cess pool 8 Sewage lagoon 11 Fuel storage 15 Oil well/Gas well
 3 Watertight sewer lines 6 Seepage pit 9 Feedyard 12 Fertilizer storage 16 Other (specify below)
 13 Insecticide storage
 Direction from well? West How many feet? 60

FROM	TO	LITHOLOGIC LOG	FROM	TO	PLUGGING INTERVALS
0	30	Brown Clay			
30	40	(Fine - Med) Gravel			
40	52	(Med) Gravel			
52	54	Limestone + Shale			

7 CONTRACTOR'S OR LANDOWNER'S CERTIFICATION: This water well was (1) constructed, (2) reconstructed, or (3) plugged under my jurisdiction and was completed on (mo/day/year) Aug. 16. 88 and this record is true to the best of my knowledge and belief. Kansas Water Well Contractor's License No. 234 This Water Well Record was completed on (mo/day/yr) Aug. 28. 88 under the business name of Blue Valley Drilling by (signature) Elin Strubbe