


1 LOCATION OF WATER WELL: County: Geary Fraction: SW 1/4 SW 1/4 SW 1/4 Section Number: 8 Township Number: T 12 S Range Number: R 6 E

Distance and direction from nearest town or city street address of well if located within city? ON T. Hill Road 1/4 OF A Mile To Old Stage Rd. + From Goodview Plaza Go South, Go Left To Carolina Rd + Go 1/2 Mile N

2 WATER WELL OWNER: Robert Brent
 RR#, St. Address, Box #: 1318 Belvoir
 City, State, ZIP Code: J. C. Kansas 66441
 Board of Agriculture, Division of Water Resources
 Application Number:

3 LOCATE WELL'S LOCATION WITH AN "X" IN SECTION BOX:

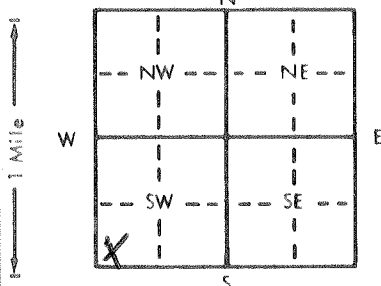

4 DEPTH OF COMPLETED WELL: 81 ft. ELEVATION:

Depth(s) Groundwater Encountered 1. 30.2 ft. 2. ft. 3. ft.

WELL'S STATIC WATER LEVEL: 30 ft. below land surface measured on mo/day/yr

Pump test data: Well water was ft. after hours pumping gpm

Est. Yield: 20 gpm; Well water was ft. after hours pumping gpm

Bore Hole Diameter: 9 in. to 81 ft., and in. to ft.

WELL WATER TO BE USED AS:
 1 Domestic 3 Feedlot 6 Oil field water supply 9 Dewatering 12 Other (Specify below)
 2 Irrigation 4 Industrial 7 Lawn and garden only 10 Monitoring well

Was a chemical/bacteriological sample submitted to Department? Yes No; If yes, mo/day/yr sample was submitted

Water Well Disinfected? Yes No

5 TYPE OF CASING USED:
 1 Steel 3 RMP (SR) 5 Wrought iron 8 Concrete tile CASING JOINTS: Gued Clamped
 2 PVC 4 ABS 6 Asbestos-Cement 9 Other (specify below) Welded Seamed
 7 Fiberglass Threaded

Blank casing diameter: 5 in. to 81 ft., Dia. in. to ft., Dia. in. to ft.

Casing height above land surface: 2' in., weight 50.40 lbs./ft. Wall thickness or gauge No.

TYPE OF SCREEN OR PERFORATION MATERIAL:
 1 Steel 3 Stainless steel 5 Fiberglass 7 PVC 10 Asbestos-cement
 2 Brass 4 Galvanized steel 6 Concrete tile 8 RMP (SR) 11 Other (specify)
 12 None used (open hole)

SCREEN OR PERFORATION OPENINGS ARE:
 1 Continuous slot 3 Mill slot 31/1000's 5 Gauzed wrapped 8 Saw cut 11 None (open hole)
 2 Louvered shutter 4 Key punched 6 Wire wrapped 9 Drilled holes
 7 Torch cut 10 Other (specify)

SCREEN-PERFORATED INTERVALS: From 61 ft. to 81 ft., From ft. to ft.

GRAVEL PACK INTERVALS: From 20 ft. to 81 ft., From ft. to ft.

6 GROUT MATERIAL: 1 Neat cement 2 Cement grout 3 Bentonite 4 Other

Grout Intervals: From 0 ft. to 20 ft., From ft. to 81 ft. to Embarking From ft. to ft.

What is the nearest source of possible contamination:
 1 Septic tank 4 Lateral lines 7 Pit privy 10 Livestock pens 14 Abandoned water well
 2 Sewer lines 5 Cess pool 8 Sewage lagoon 11 Fuel storage 15 Oil well/Gas well
 3 Watertight sewer lines 6 Seepage pit 9 Feedyard 12 Fertilizer storage 16 Other (specify below)
 13 Insecticide storage

Direction from well? North How many feet? 150'

FROM	TO	LITHOLOGIC LOG	FROM	TO	PLUGGING INTERVALS
0	12	Brown Clay			
12	24	Brown Shale			
24	32	Limestone			
32	42	Grey shale			
42	47	Brown shale			
47	51	Limestone			
51	56	Brown shale			
56	57	Limestone			
57	62	Grey shale			
62	65	Limestone (Water)			
65	75	Grey shale			
75	81	Limestone			

7 CONTRACTOR'S OR LANDOWNER'S CERTIFICATION: This water well was (1) constructed, (2) reconstructed, or (3) plugged under my jurisdiction and was completed on (mo/day/year) 8/20/90 and this record is true to the best of my knowledge and belief. Kansas Water Well Contractor's License No. 451/90 This Water Well Record was completed on (mo/day/yr) 8/3/90 under the business name of Holdeman Well Drilling by (signature) Way H