


1 LOCATION OF WATER WELL: County: Greary Fraction: NW 1/4 NW 1/4 NW 1/4 Section Number: 11 Township Number: T 12 S Range Number: R 6 NW

Distance and direction from nearest town or city street address of well if located within city? Junction City, Mo. To East 4.5 miles To Exit 303 & 2 miles South

2 WATER WELL OWNER: Rick Zigler RR#, St. Address, Box #: RR #2 Box 23A City, State, ZIP Code: Junction City, Kansas 66441 Board of Agriculture, Division of Water Resources Application Number:

3 LOCATE WELL'S LOCATION WITH AN "X" IN SECTION BOX: 4 DEPTH OF COMPLETED WELL: 57 ft. ELEVATION: Depth(s) Groundwater Encountered: 1. 36 ft. 2. ft. 3. ft.

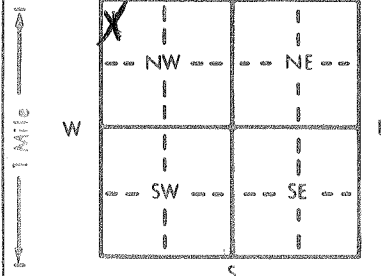

WELL'S STATIC WATER LEVEL: 35 ft. below land surface measured on mo/day/yr Pump test data: Well water was ft. after hours pumping gpm Est. Yield: 20 gpm Well water was ft. after hours pumping gpm Bore Hole Diameter: 8 in. to ft., and in. to ft. WELL WATER TO BE USED AS: 5 Public water supply 8 Air conditioning 11 Injection well 2 Irrigation 4 Industrial 7 Lawn and garden only 10 Monitoring well 3 Feedlot 6 Oil field water supply 9 Dewatering 12 Other (Specify below) Was a chemical/bacteriological sample submitted to Department? Yes No; If yes, mo/day/yr sample was submitted Water Well Disinfected? Yes No

5 TYPE OF BLANK CASING USED: 1 Steel 3 RMP (SR) 5 Wrought iron 8 Concrete tile CASING JOINTS: Glued Sealed 2 PVC 4 ABS 7 Fiberglass 9 Other (specify below) Welded Threaded Blank casing diameter: 5 in. to 37 ft., Dia. in. to ft., Dia. in. to ft. Casing height above land surface: 2 in., weight sch. 40 lbs./ft. Wall thickness or gauge No.

TYPE OF SCREEN OR PERFORATION MATERIAL: 1 Steel 3 Stainless steel 5 Fiberglass 8 RMP (SR) 10 Asbestos-cement 2 Brass 4 Galvanized steel 6 Concrete tile 9 ABS 11 Other (specify) 12 None used (open hole) SCREEN OR PERFORATION OPENINGS ARE: 1 Continuous slot 3 Mill slot 31/1000 5 Gauzed wrapped 8 Saw cut 11 None (open hole) 2 Louvered shutter 4 Key punched 6 Wire wrapped 9 Drilled holes 10 Other (specify) 7 Torch cut

SCREEN-PERFORATED INTERVALS: From 37 ft. to 57 ft., From ft. to ft. GRAVEL PACK INTERVALS: From 20 ft. to 57 ft., From ft. to ft.

6 GROUT MATERIAL: 1 Neat cement 2 Cement grout 3 Bentonite 4 Other Grout Intervals: From 0 ft. to 20 ft., From ft. to Enviropack ft., From ft. to ft. What is the nearest source of possible contamination: 1 Septic tank 4 Lateral lines 7 Pit privy 10 Livestock pens 14 Abandoned water well 2 Sewer lines 5 Cess pool 8 Sewage lagoon 11 Fuel storage 15 Oil well/Gas well 3 Watertight sewer lines 6 Seepage pit 9 Feedyard 12 Fertilizer storage 16 Other (specify below) 13 Insecticide storage Direction from well? North How many feet? 80 yds

FROM	TO	LITHOLOGIC LOG	FROM	TO	PLUGGING INTERVALS
0	30	Brown Clay			
30	36	Grey shale			
36	40	Gravel Layer			
40	60	Brown Shale			

7 CONTRACTOR'S OR LANDOWNER'S CERTIFICATION: This water well was (1) constructed, (2) reconstructed, or (3) plugged under my jurisdiction and was completed on (mo/day/year) 1. 18/89 and this record is true to the best of my knowledge and belief. Kansas Water Well Contractor's License No. 451 This Water Well Record was completed on (mo/day/yr) 2. 9/89 under the business name of Naldeman Well Drilling by (signature) Craig