

WATER WELL RECORD


Form WWC-5

Division of Water Resources App. No.

1 LOCATION OF WATER WELL: County: GERRY Fraction 1/4 NW 1/4 NW 1/4 NW 1/4 Section Number 2 Township No. T 12 S Range Number R 6 E W

Street/Rural Address of Well Location; if unknown, distance & direction from nearest town or intersection: If at owner's address, check here [] Global Positioning System (GPS) information: Latitude: 39.04317 Longitude: 96.74210 Elevation: 1122

2 WATER WELL OWNER: Robert Cox RR#, Street Address, Box #: 12812 Clerks Creek Rd. City, State, ZIP Code: Junction City, KS 66441 Collection Method: GPS unit (Make/Model: GARMIN ETREX) Est. Accuracy: 3-5 m

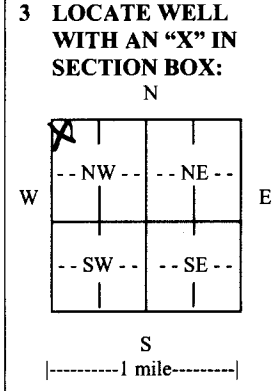

to 240 ft. WELL WATER TO BE USED AS: [X] Geothermal [] Injection well [] Domestic [] Feedlot [] Oil field water supply [] Dewatering [] Other (Specify below) [] Irrigation [] Industrial [] Domestic-lawn & garden [] Monitoring well Was a chemical/bacteriological sample submitted to Department? [] Yes [X] No If yes, mo/day/yr sample was submitted: Water well disinfected? [] Yes [X] No

, Weight: lbs./ft., Wall thickness or gauge No. 5/8" TYPE OF SCREEN OR PERFORATION MATERIAL: [] Steel [] Stainless Steel [] PVC [] Other (Specify) [] Brass [] Galvanized Steel [] None used (open hole) SCREEN OR PERFORATION OPENINGS ARE: [] Continuous slot [] Mill slot [] Gauze wrapped [] Torch cut [] Drilled holes [] None (open hole) [] Louvered shutter [] Key punched [] Wire wrapped [] Saw cut [] 

Fuel storage [] Abandoned water well [] Watertight sewer lines [] Seepage pit [] Feedyard [] Fertilizer storage [] Oil well/gas well UNDERNEATH BASEMENT FLOOR Direction from well: Distance from well:

Table with columns: FROM, TO, LITHOLOGIC LOG, FROM, TO, LITHO. LOG (cont.) or PLUGGING INTERVALS. Rows include: 0-15 CLAY, 15-22 GRAVEL, 22-33 CLAY, 33-62 SHALE, 62-71 LIMESTONE, 71-120 SHALE, 120-131 LIMESTONE, 131-137 LIMESTONE, WEATHERED, H2O, 137-165 SHALE. Plugging intervals: 1-240, 1-235, 1-215, 1-230.

7 CONTRACTOR'S OR LANDOWNER'S CERTIFICATION: This water well was [X] constructed, [] reconstructed, or [] plugged under my jurisdiction and was completed on (mo/day/year) 2-16-2011 and this record is true to the best of my knowledge and belief. Kansas Water Well Contractor's License No. 794, This Water Well Record was completed on (mo/day/year) 5-27-2011 under the business name of Associated Drilling, Inc. by (signature) []

INSTRUCTIONS: Use typewriter or ball point pen. PLEASE PRESS FIRMLY and PRINT clearly. Please fill in blanks and check the correct answers. Send three copies (white, blue, pink) to Kansas Department of Health and Environment, Bureau of Water, Geology Section, 1000 SW Jackson St., Suite 420, Topeka, Kansas 66612-1367. Telephone 785-296-5522. Send one copy to WATER WELL OWNER and retain one for your records. Include fee of \$5.00 for each constructed well. Visit us at http://www.kdheks.gov/waterwell/index.html.