


WATER WELL RECORD Form WWC-5 KSA 82a-1212

LOCATION OF WATER WELL: County: Geary Fraction: SE 1/4 NW 1/4 NE 1/4 Section Number: 3 Township Number: T 12S Range Number: R 7E E/W

Distance and direction from nearest town or city street address of well if located within city?
East on Interstate 70 from Junction City to McDowell Creek Road, go South 5 miles, right hand side

WATER WELL OWNER: Charles White of R road.
 RR#, St. Address, Box #: Ash Street Board of Agriculture, Division of Water Resources
 City, State, ZIP Code: Junction City, Ks. 66441 Application Number:

LOCATE WELL'S LOCATION WITH AN "X" IN SECTION BOX:

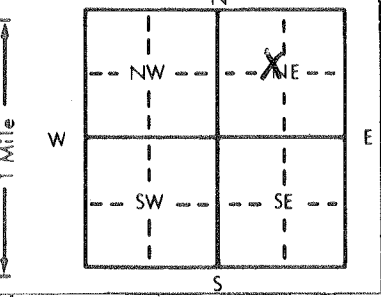

4 DEPTH OF COMPLETED WELL: 140' ft. ELEVATION: ft.
 Depth(s) Groundwater Encountered 1. 60' ft. 2. ft. 3. ft.
 WELL'S STATIC WATER LEVEL: 58' ft. below land surface measured on mo/day/yr 8-13-1982
 Pump test data: Well water was 140' ft. after 3/4 hours pumping 10 gpm
 Est. Yield 10 gpm: Well water was ft. after hours pumping gpm
 Bore Hole Diameter: 8" in. to 140' ft., and in. to ft.
 WELL WATER TO BE USED AS:
 1 Domestic 3 Feedlot 6 Oil field water supply 9 Dewatering 12 Other (Specify below)
 2 Irrigation 4 Industrial 7 Lawn and garden only 10 Observation well
 Was a chemical/bacteriological sample submitted to Department? Yes No ; If yes, mo/day/yr sample was submitted
 Water Well Disinfected? Yes No

5 TYPE OF BLANK CASING USED:
 1 Steel 3 RMP (SR) 5 Wrought iron 8 Concrete tile CASING JOINTS: Glued Clamped
 2 PVC 4 ABS 6 Asbestos-Cement 9 Other (specify below) Welded
 7 Fiberglass Threaded

Blank casing diameter: 5" in. to 100' ft., Dia in. to ft., Dia in. to ft.
 Casing height above land surface: 12 in., weight 3 lbs./ft. Wall thickness or gauge No. 258

TYPE OF SCREEN OR PERFORATION MATERIAL:
 1 Steel 3 Stainless steel 5 Fiberglass 7 PVC 10 Asbestos-cement
 2 Brass 4 Galvanized steel 6 Concrete tile 8 RMP (SR) 11 Other (specify)
 9 ABS 12 None used (open hole)

SCREEN OR PERFORATION OPENINGS ARE:
 1 Continuous slot 3 Mill slot 5 Gauzed wrapped 8 Saw cut 11 None (open hole)
 2 Louvered shutter 4 Key punched 6 Wire wrapped 9 Drilled holes

SCREEN-PERFORATED INTERVALS: From 100' ft. to 140' ft., From ft. to ft.
 GRAVEL PACK INTERVALS: From 10' ft. to 140' ft., From ft. to ft.

6 GROUT MATERIAL: 1 Neat cement 2 Cement grout 3 Bentonite 4 Other
 Grout Intervals: From 0 ft. to 10 ft., From ft. to ft.

What is the nearest source of possible contamination:
 1 Septic tank 4 Lateral lines 7 Pit privy 10 Livestock pens 14 Abandoned water well
 2 Sewer lines 5 Cess pool 8 Sewage lagoon 11 Fuel storage 15 Oil well/Gas well
 3 Watertight sewer lines 6 Seepage pit 9 Feedyard 12 Fertilizer storage 16 Other (specify below) POND

Direction from well? SE How many feet? 50'

FROM	TO	LITHOLOGIC LOG	FROM	TO	LITHOLOGIC LOG
1	4	Rock			
4	22	Clay			
22	24	Rock			
24	42	Clay			
42	44	Rock			
44	60	Clay			
60	62	Limerock			
62	78	Clay			
78	94	Shale & Rock			
94	140	Limerock			
140		Stopped in Shale			

7 CONTRACTOR'S OR LANDOWNER'S CERTIFICATION: This water well was (1) constructed, (2) reconstructed, or (3) plugged under my jurisdiction and was completed on (mo/day/year) August 13, 1982 and this record is true to the best of my knowledge and belief. Kansas Water Well Contractor's License No. 361 This Water Well Record was completed on (mo/day/yr) Sept. 10, 1982 under the business name of Cox - Beswick Irrigation Service, Inc. by (signature) Francis Cox

INSTRUCTIONS: Use typewriter or ball point pen, PLEASE PRESS FIRMLY and PRINT clearly. Please fill in blanks, underline or circle the correct answers. Send top three copies to Kansas Department of Health and Environment, Division of Environment, Environmental Geology Section, Topeka, KS 66620. Send one to WATER WELL OWNER and retain one for your records.