


1] LOCATION OF WATER WELL: County: Geary Fraction: NW 1/4 NW 1/4 NW 1/4 Section Number: 7 Township Number: T 12 S Range Number: R 7 EW
 Distance and direction from nearest town or city street address of well if located within city? From J.C. Go 3 miles South to Humboldt Rd. + Go 3 miles South

2] WATER WELL OWNER: C.A. Zumbrohn Board of Agriculture, Division of Water Resource
 RR#, St. Address, Box #: RR 2 Box 44 Application Number:
 City, State, ZIP Code: J.C. KS 66441

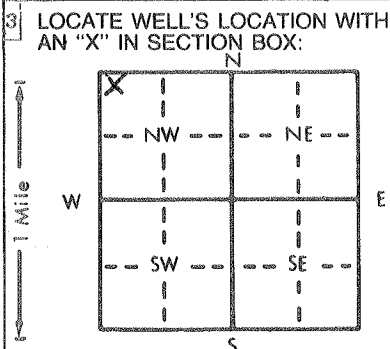

4] DEPTH OF COMPLETED WELL: 80 ft. ELEVATION:
 Depth(s) Groundwater Encountered 1. 53 ft. 2. ft. 3. ft.
 WELL'S STATIC WATER LEVEL: 35 ft. below land surface measured on mo/day/yr
 Pump test data: Well water was ft. after hours pumping gpm
 Est. Yield: 20 gpm; Well water was ft. after hours pumping gpm
 Bore Hole Diameter: 8 in. to 8.0 in. to ft.
 WELL WATER TO BE USED AS: 5 Public water supply 8 Air conditioning 11 Injection well
 Domestic 3 Feedlot 6 Oil field water supply 9 Dewatering 12 Other (Specify below)
 2 Irrigation 4 Industrial 7 Lawn and garden only 10 Monitoring well
 Was a chemical/bacteriological sample submitted to Department? Yes.....No. ; If yes, mo/day/yr sample was submitted

5] TYPE OF BLANK CASING USED: 5 Wrought iron 8 Concrete tile CASING JOINTS: Glued Clamped
 1 Steel 3 RMP (SR) 6 Asbestos-Cement 9 Other (specify below) Welded
 PVC 4 ABS 7 Fiberglass Threaded
 Blank casing diameter: 5 in. to 60 ft., Dia. in. to in. to ft.
 Casing height above land surface: 24 in., weight Sch. 40 lbs./ft. Wall thickness or gauge No.

TYPE OF SCREEN OR PERFORATION MATERIAL: 7 PVC 10 Asbestos-cement
 1 Steel 3 Stainless steel 5 Fiberglass 8 RMP (SR) 11 Other (specify)
 2 Brass 4 Galvanized steel 6 Concrete tile 9 ABS 12 None used (open hole)

SCREEN OR PERFORATION OPENINGS ARE: 5 Gauzed wrapped 8 Saw cut 11 None (open hole)
 1 Continuous slot 3 Mill slot 31/1000 6 Wire wrapped 9 Drilled holes
 2 Louvered shutter 4 Key punched 7 Torch cut 10 Other (specify)

SCREEN-PERFORATED INTERVALS: From 60 ft. to 80 ft., From ft. to ft.
 GRAVEL PACK INTERVALS: From 20 ft. to 80 ft., From ft. to ft.
 From ft. to ft., From ft. to ft.

6] GROUT MATERIAL: 1 Neat cement 2 Cement grout Bentonite Environmentally 4 Other
 Grout Intervals: From 0 ft. to 20 ft., From ft. to ft., From ft. to ft.
 What is the nearest source of possible contamination:
 1 Septic tank 4 Lateral lines 7 Pit privy 10 Livestock pens 14 Abandoned water well
 2 Sewer lines 5 Cess pool 8 Sewage lagoon 11 Fuel storage 15 Oil well/Gas well
 3 Watertight sewer lines 6 Seepage pit 9 Feedyard 12 Fertilizer storage 16 Other (specify below)
 13 Insecticide storage
 Direction from well? North East How many feet? 70'

FROM	TO	LITHOLOGIC LOG	FROM	TO	PLUGGING INTERVALS
0	18	Brown Clay			
18	19	Lime Stone			
19	25	Gray Shale			
25	27	Limestone			
27	35	Yellow Shale			
35	41	Brown Shale			
41	44	Limestone			
44	53	Gray Shale			
53	58	Limestone			
58	69	Gray Shale			
69	70	Lime Stone			
70	74	Gray Shale			
74	77	Limestone			
77	80	Gray Shale			

7] CONTRACTOR'S OR LANDOWNER'S CERTIFICATION: This water well was (1) constructed (2) reconstructed, or (3) plugged under my jurisdiction and was completed on (mo/day/year) 7/24/89 and this record is true to the best of my knowledge and belief. Kansas Water Well Contractor's License No. 451 This Water Well Record was completed on (mo/day/yr) 8/29/89 under the business name of Aaldeman well Drilling by (signature) Craig H