


1 LOCATION OF WATER WELL: Fraction NE 1/4 NE 1/4 NE 1/4 Section Number 12 Township Number T 12 S Range Number R 7 E  
 County: Geary

Distance (and direction) from nearest town or city street address of well if located within city?  
Grandview Plaza east of Junction City 7 mi east take David Creek road road SE across 4 town

2 WATER WELL OWNER: Carl Glessner sections 04 mi on east side of road  
 RR#, St. Address, Box # RR 2 Junction City Kans 66441  
 City, State, ZIP Code Junction City Kans 66441

3 LOCATE WELL'S LOCATION WITH AN "X" IN SECTION BOX: NE 1/4  
 4 DEPTH OF COMPLETED WELL: 45 ft. ELEVATION: 18 ft.

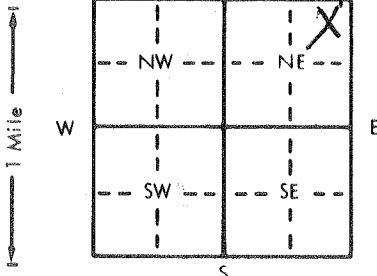

Depth(s) Groundwater Encountered 1. 18 ft. 2. 18 ft. 3. 18 ft.  
 WELL'S STATIC WATER LEVEL 18 ft. below land surface measured on mo/day/yr Oct. 26 84  
 Pump test data: Well water was 40 gpm. Well water was 18 ft. after 6 1/2 hours pumping 45 gpm  
 Est. Yield 40 gpm. Well water was 18 ft. after 6 1/2 hours pumping 45 gpm  
 Bore Hole Diameter 10 in. to 18 ft., and 6 1/2 in. to 45 ft.  
 WELL WATER TO BE USED, AS:  
 1 Domestic  3 Feedlot  6 Oil field water supply  9 Dewatering  12 Other (Specify below)  
 2 Irrigation  4 Industrial  7 Lawn and garden only  10 Observation well  
 Was a chemical/bacteriological sample submitted to Department? Yes X No X; If yes, mo/day/yr sample was submitted  
 Water Well Disinfected? Yes X No X

5 TYPE OF BLANK CASING USED:  
 1 Steel  3 RMP (SR)  5 Wrought iron  8 Concrete tile CASING JOINTS: Glued X Clamped X  
 2 PVC  4 ABS  6 Asbestos-Cement  9 Other (specify below) Welded X  
 7 Fiberglass Threaded X

Blank casing diameter 5 in. to 16 ft. Dia. 16 in. to 45 ft. Dia. 3 dia in. to perforated  
 Casing height above land surface 14 in., weight 267 lbs./ft. Wall thickness or gauge No. 45

TYPE OF SCREEN OR PERFORATION MATERIAL:  
 1 Steel  3 Stainless steel  5 Fiberglass  7 PVC  10 Asbestos-cement  
 2 Brass  4 Galvanized steel  6 Concrete tile  8 RMP (SR)  11 Other (specify) perforated  
 12 None used (open hole)

SCREEN OR PERFORATION OPENINGS ARE:  
 1 Continuous slot  3 Mill slot  5 Gauzed wrapped  8 Saw cut  11 None (open hole)  
 2 Louvered shutter  4 Key punched  6 Wire wrapped  9 Drilled holes  
 7 Torch cut  10 Other (specify)

SCREEN-PERFORATED INTERVALS: From 16 ft. to 45 ft. From 16 ft. to 45 ft.  
 GRAVEL PACK INTERVALS: From 45 ft. to 16 ft. From 45 ft. to 16 ft.

6 GROUT MATERIAL:  1 Neat cement  2 Cement grout  3 Bentonite  4 Other  
 Grout Intervals: From 5 ft. to 16 ft. From 5 ft. to 16 ft.

What is the nearest source of possible contamination:  
 1 Septic tank  4 Lateral lines  7 Pit privy  10 Livestock pens  14 Abandoned water well  
 2 Sewer lines  5 Cess pool  8 Sewage lagoon  11 Fuel storage  15 Oil well/Gas well  
 3 Watertight sewer lines  6 Seepage pit  9 Feedyard  12 Fertilizer storage  16 Other (specify below)  
 13 Insecticide storage livestock pens

Direction from well? East Well is on High side of creek 40 many feet?

FROM	TO	LITHOLOGIC LOG	FROM	TO	LITHOLOGIC LOG
0	7	Top Soil			
7	13	Shale rock, Hard			
13	18	gravel creek gravel & water			
18	45	Blue shale			

7 CONTRACTOR'S OR LANDOWNER'S CERTIFICATION: This water well was  (1) constructed, (2) reconstructed, or (3) plugged under my jurisdiction and was completed on (mo/day/year) Oct 26 84 and this record is true to the best of my knowledge and belief. Kansas Water Well Contractor's License No. 237 This Water Well Record was completed on (mo/day/yr) Nov 2 84 under the business name of Strader Drilling Co by (signature) Harold Strader

INSTRUCTIONS: Use typewriter or ball point pen, PLEASE PRESS FIRMLY and PRINT clearly. Please fill in blanks, underline or circle the correct answers. Send top three copies to Kansas Department of Health and Environment, Division of Environment, Environmental Geology Section, Topeka, KS 66620. Send one to WATER WELL OWNER and retain one for your records.