


1 LOCATION OF WATER WELL: County: GOVY Fraction: NE 1/4 NE 1/4 NE 1/4 Section Number: 21 Township Number: T 12 S Range Number: R 7 E

Distance and direction from nearest town or city street address of well if located within city? From Junction City Go 6 miles East on I 70 to Humbolt Road + Go 6.5 miles South thru 60 3 mile west

2 WATER WELL OWNER: Joe Miller
 RR#, St. Address, Box #: 4340 Dorr Haven Lane
 City, State, ZIP Code: St George, Kansas 66535
 Board of Agriculture, Division of Water Resources
 Application Number:

3 LOCATE WELL'S LOCATION WITH AN "X" IN SECTION BOX:

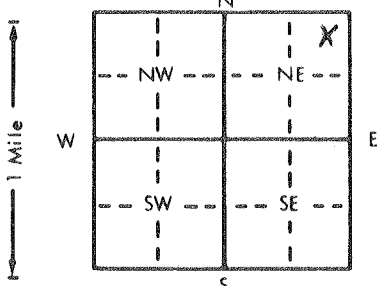

4 DEPTH OF COMPLETED WELL: 36' ft. ELEVATION: _____

Depth(s) Groundwater Encountered: 1. 22 ft. 2. _____ ft. 3. _____ ft.

WELL'S STATIC WATER LEVEL: 15 ft. below land surface measured on mo/day/yr _____

Pump test data: Well water was _____ ft. after _____ hours pumping _____ gpm

Est. Yield: 6 gpm: Well water was _____ ft. after _____ hours pumping _____ gpm

Bore Hole Diameter: 1.0 in. to 4.0 ft., and _____ in. to _____ ft.

WELL WATER TO BE USED AS: 5 Public water supply 8 Air conditioning 11 Injection well

1 Domestic 3 Feedlot 6 Oil field water supply 9 Dewatering 12 Other (Specify below)

2 Irrigation 4 Industrial 7 Lawn and garden only 10 Monitoring well

Was a chemical/bacteriological sample submitted to Department? Yes _____ No _____ If yes, mo/day/yr sample was submitted _____

Water Well Disinfected? Yes No

5 TYPE OF BLANK CASING USED: 1 Steel 3 RMP (SR) 5 Wrought iron 8 Concrete tile CASING JOINTS: Glued Clamped

2 PVC 4 ABS 6 Asbestos-Cement 9 Other (specify below) Welded _____

Blank casing diameter: 5 in. to 20 ft., Dia _____ in. to _____ ft., Dia _____ in. to _____ ft.

Casing height above land surface: 2' in., weight 56.40 lbs./ft. Wall thickness or gauge No. _____

TYPE OF SCREEN OR PERFORATION MATERIAL: 1 Steel 3 Stainless steel 5 Fiberglass 8 RMP (SR) 10 Asbestos-cement

2 Brass 4 Galvanized steel 6 Concrete tile 9 ABS 11 Other (specify) _____

SCREEN OR PERFORATION OPENINGS ARE: 1 Continuous slot 3 Mill slot 5 Gauzed wrapped 8 Saw cut 11 None (open hole)

2 Louvered shutter 4 Key punched 6 Wire wrapped 9 Drilled holes

SCREEN-PERFORATED INTERVALS: From 20 ft. to 36 ft., From _____ ft. to _____ ft.

GRAVEL PACK INTERVALS: From 20 ft. to 36 ft., From _____ ft. to _____ ft.

6 GROUT MATERIAL: 1 Neat cement 2 Cement grout 3 Bentonite 4 Other _____

Grout intervals: From 0 ft. to 20 ft., From _____ ft. to _____ ft.

What is the nearest source of possible contamination: None Close 10 Livestock pens 14 Abandoned water well

1 Septic tank 4 Lateral lines 7 Pit privy 11 Fuel storage 15 Oil well/Gas well

2 Sewer lines 5 Cess pool 8 Sewage lagoon 12 Fertilizer storage 16 Other (specify below)

3 Watertight sewer lines 6 Seepage pit 9 Feedyard 13 Insecticide storage

Direction from well? _____ How many feet? _____

FROM	TO	LITHOLOGIC LOG	FROM	TO	PLUGGING INTERVALS
0	17	Brown Clay			
17	19	Brown Clay + some gravel			
19	22	Brown Clay			
22	29	Brown Clay + Gravel (Water)			
29	31	Dark gray shale			
31	35	Hard Rock + Flint Rock			
35	40	Brown shale			

7 CONTRACTOR'S OR LANDOWNER'S CERTIFICATION: This water well was (1) constructed, (2) reconstructed, or (3) plugged under my jurisdiction and completed on (mo/day/year) 7/12/91 and this record is true to the best of my knowledge and belief. Kansas Water Well Contractor's License No. 451 This Water Well Record was completed on (mo/day/yr) 8/10/91 under the business name of Haldeman Well Drilling by (signature) Craig A. CNO/PC