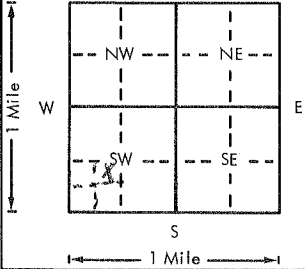


USE TYPEWRITER OR BALL POINT PEN-PRESS FIRMLY, PRINT CLEARLY.

WATER WELL RECORD  
KSA 82a-1201-1215

Kansas Department of Health and Environment-Division of Environment  
(Water well Contractors)  
Topeka, Kansas 66620

1. Location of well:		County <u>Geary</u>	Fraction <u>NE 1/4 SW 1/4 SW 1/4</u>	Section number <u>21</u>	Township number <u>T 12 S</u>	Range number <u>R 7 E</u>
2. Distance and direction from nearest town or city: <u>8 miles east</u> Street address of well location if in city: <u>2 miles south</u> <u>Junction City</u>			3. Owner of well: <u>Eldon Steiford</u> R.R. or street: <u>R.R. # 2</u> City, state, zip code: <u>Junction City</u>			
4. Locate with "X" in section below: N  W E S 1 Mile			Sketch map:			6. Bore hole dia. <u>8</u> in. Completion date _____ Well depth <u>25</u> ft. <u>12/21/76</u>
5. Type and color of material			From	To	7. <input type="checkbox"/> Cable tool <input checked="" type="checkbox"/> Rotary <input type="checkbox"/> Driven <input type="checkbox"/> Dug <input type="checkbox"/> Hollow rod <input type="checkbox"/> Jetted <input type="checkbox"/> Bored <input type="checkbox"/> Reverse rotary	
Top soil			0	16	8. Use: <input checked="" type="checkbox"/> Domestic <input type="checkbox"/> Public supply <input type="checkbox"/> Industry <input type="checkbox"/> Irrigation <input type="checkbox"/> Air conditioning <input type="checkbox"/> Stock <input type="checkbox"/> Lawn <input type="checkbox"/> Oil field water <input type="checkbox"/> Other	
Creek gravel			16	21	9. Casing: Material <u>plst</u> Height: Above or below Threaded <input type="checkbox"/> Welded <u>gl</u> Surface <u>18</u> in. RMP <input checked="" type="checkbox"/> PVC <input type="checkbox"/> Weight _____ lbs./ft. Dia. <u>5</u> in. to <u>25</u> ft. depth Wall Thickness: inches or Dia. _____ in. to _____ ft. depth gauge No. <u>9.258</u>	
Bed Rock			21	25	10. Screen: Manufacturer's name _____ <u>Western Plastics</u> Type <u>RMP</u> Dia. <u>5"</u> Slot/gauze <u>3/32</u> Length <u>10'</u> Set between <u>15</u> ft. and <u>25</u> ft. Gravel pack? <input checked="" type="checkbox"/> Yes <input type="checkbox"/> No Size range of material <u>1/16 to 3/8</u>	
					11. Static water level: _____ mo./day/yr. <u>16</u> ft. below land surface Date <u>12/15/76</u>	
					12. Pumping level below land surfaces: _____ ft. after _____ hrs. pumping _____ g.p.m. _____ ft. after _____ hrs. pumping _____ g.p.m. Estimated maximum yield <u>15</u> g.p.m.	
					13. Water sample submitted: _____ mo./day/yr. <input type="checkbox"/> Yes <input checked="" type="checkbox"/> No Date _____	
					14. Well head completion: <input checked="" type="checkbox"/> Pitless adapter _____ inches above grade	
					15. Well grouted? <u>Yes</u> With: <input checked="" type="checkbox"/> Neat cement <input type="checkbox"/> Bentonite <input type="checkbox"/> Concrete Depth: From <u>0</u> ft. to <u>10</u> ft.	
					16. Nearest source of possible contamination: ft. <u>60</u> Direction <u>NW</u> Type <u>cornal</u> Well disinfected upon completion? <input type="checkbox"/> Yes <input type="checkbox"/> No	
					17. Pump: <input type="checkbox"/> Not installed Manufacturer's name <u>Dempster</u> Model number _____ HP <u>1/2</u> Volts _____ Length of drop pipe <u>20'</u> ft. capacity _____ g.p.m. Type: <input checked="" type="checkbox"/> Submersible <input type="checkbox"/> Turbine <input type="checkbox"/> Jet <input type="checkbox"/> Reciprocating <input type="checkbox"/> Centrifugal <input type="checkbox"/> Other	
			(Use a second sheet if needed)			
18. Elevation:		19. Remarks:		20. Water well contractor's certification: This well was drilled under my jurisdiction and this report is true to the best of my knowledge and belief. <u>Rader Drilling Co.</u> 194 Business name _____ License No. _____ Address <u>Carlton, Kansas 67429</u> Signed <u>Robert C Rader</u> Date <u>2-11-77</u> Authorized representative		
Topography: <input type="checkbox"/> Hill <input type="checkbox"/> Slope <input type="checkbox"/> Upland <input type="checkbox"/> Valley						

T 12  
R 7  
E  
21  
NE SW  
1/4 1/4 1/4