

Sent 11/30/77


USE TYPEWRITER OR BALL POINT PEN-PRESS FIRMLY, PRINT CLEARLY.

WATER WELL RECORD  
KSA 82a-1201-1215

Kansas Department of Health and Environment-Division of Environment (Water well Contractors) Topeka, Kansas 66620

1. Location of well: County Gearg Fraction NW 1/4 NW 1/4 SW 1/4 Section number 30 Township number T 12 S R 8 Range number East of 6th PM

2. Distance and direction from nearest town or city: last of junction city about 10 mi to the south on 1st the about 8 mi South on the road across creek to the  
 Street address of well location if in city:  
 4. Locate with "X" in section below: on West side of road east of creek

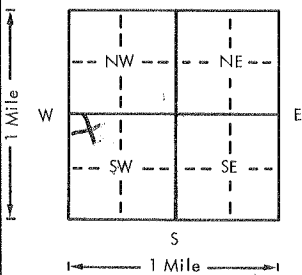

3. Owner of well: Jack S. Barnes  
 R.R. or street: RR1  
 City, state, zip code: Alta Vista Kans 66834

6. Bore hole dia. 10 in. Completion date 10-14-77  
 Well depth 100 ft.

7.  Cable tool  Rotary  Driven  Dug  
 Hollow rod  Jetted  Bored  Reverse rotary

8. Use:  Domestic  Public supply  Industry  
 Irrigation  Air conditioning  Stock  
 Lawn  Oil field water  Other

9. Casing: Material PVC Height: Above or below  
 Threaded  Welded  Surface 14 in.  
 RMP  PVC  Weight 14 lbs./ft.  
 Dia. 5 in. to 100 ft. depth Wall Thickness: inches or  
 Dia. 5 in. to 100 ft. depth gage No. 258 Wall

5. Type and color of material	From	To
<u>top soil, Black</u>	<u>1</u>	<u>8</u>
<u>Clay, Brown</u>	<u>8</u>	<u>15</u>
<u>Rock, yellow-lime</u>	<u>15</u>	<u>18</u>
<u>Shale, Blue</u>	<u>18</u>	<u>27</u>
<u>Rock, white lime (water)</u>	<u>27</u>	<u>40</u>
<u>Shale, Blue</u>	<u>40</u>	<u>100</u>
(Use a second sheet if needed)		

10. Screen: Manufacturer's name M.P.I.

Type PVC Dia. 5 in.  
 Slot/gauze .050 Length 40 ft.  
 Set between 60 ft. and 20 ft.  
 Gravel pack?  Size range of material 1/8 X 1/4

11. Static water level: 17 ft. below land surface Date 10-14-77 mo./day/yr.

12. Pumping level below land surfaces:  
 \_\_\_ ft. after \_\_\_ hrs. pumping \_\_\_ g.p.m.  
 \_\_\_ ft. after \_\_\_ hrs. pumping \_\_\_ g.p.m.  
 Estimated maximum yield 5 g.p.m.

13. Water sample submitted: \_\_\_ Yes  No Date \_\_\_/\_\_\_/\_\_\_

14. Well head completion: NA  
 \_\_\_ Pitless adapter \_\_\_ Inches above grade

15. Well grouted?   
 With:  Neat cement  Bentonite  Concrete  
 Depth: From 15 ft. to 5 ft.

16. Nearest source of possible contamination: ft. 200 Direction North Type ditch  
 Well disinfected upon completion?  Yes  No

17. Pump:  Not installed  
 Manufacturer's name \_\_\_\_\_  
 Model number \_\_\_\_\_ HP \_\_\_\_\_ Volts \_\_\_\_\_  
 Length of drop pipe \_\_\_\_\_ ft. capacity \_\_\_\_\_ g.p.m.  
 Type:  Submersible  Turbine  
 Jet  Reciprocating  
 Centrifugal  Other

18. Elevation:  
 Topography:  
 Hill  
 Slope  
 Upland  
 Valley

19. Remarks:

20. Water well contractor's certification:  
 This well was drilled under my jurisdiction and this report is true to the best of my knowledge and belief.  
Strader Drilling Co 3371  
 Business name Blue Rapids License No. \_\_\_\_\_  
 Address Harold Strader  
 Signed Harold Strader Date 10-14-77  
 Authorized Representative

Forward the white, blue and pink copies to the Department of Health and Environment

Form WWC-5

6th PM  
 1-8-80-50  
 Sec  
 1-11-77  
 1-11-77