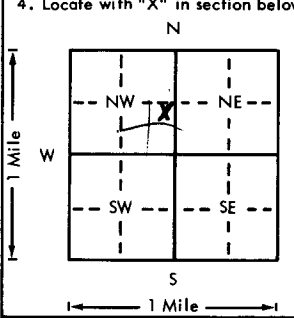
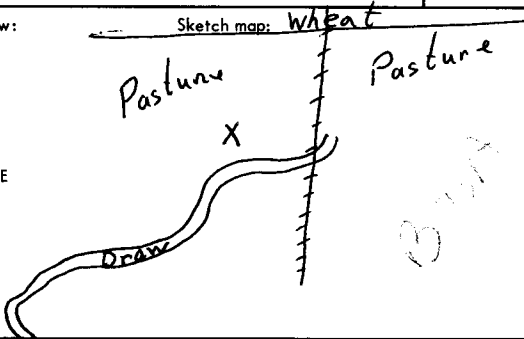
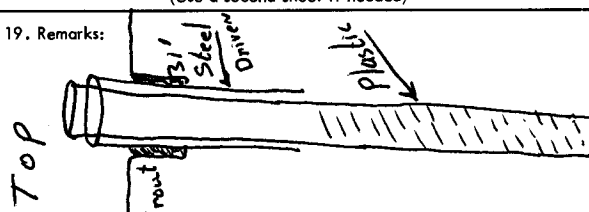


USE TYPEWRITER OR BALL POINT PEN-PRESS FIRMLY, PRINT CLEARLY.

WATER WELL RECORD
KSA 82a-1201-1215

Kansas Department of Health and Environment-Division of Environment (Water well Contractors) Topeka, Kansas 66620

1. Location of well:	County Dickinson	Fraction NE 1/4 SE 1/4 NW 1/4	Section number 3	Township number T 13 S R 1 E/W	Range number
2. Distance and direction from nearest town or city: 3 mile North and 3 mile West of Abilene Street address of well location if in city:			3. Owner of well: Marsteller's Rt 4 Abilene, Kan R.R. or street: City, state, zip code:		
4. Locate with "X" in section below:  Sketch map: Wheat Pasture Pasture Draw 			6. Bore hole dia. 6 1/2 in. Completion date 7-21-77 Well depth 80 ft.		
5. Type and color of material			7. <input checked="" type="checkbox"/> Cable tool <input type="checkbox"/> Rotary <input type="checkbox"/> Driven <input type="checkbox"/> Dug <input type="checkbox"/> Hollow rod <input type="checkbox"/> Jetted <input type="checkbox"/> Bored <input type="checkbox"/> Reverse rotary		
			8. Use: <input type="checkbox"/> Domestic <input type="checkbox"/> Public supply <input type="checkbox"/> Industry <input checked="" type="checkbox"/> Irrigation <input type="checkbox"/> Air conditioning <input type="checkbox"/> Stock <input type="checkbox"/> Lawn <input type="checkbox"/> Oil field water <input type="checkbox"/> Other		
			9. Casing: Material PIES Height: Above or below Threaded <input type="checkbox"/> Welded glu Surface 12 in. RMP <input checked="" type="checkbox"/> PVC Weight _____ lbs./ft. Dia. 5 in. to 31 ft. depth Wall Thickness: inches or Dia. _____ in. to _____ ft. depth gage No. 1200		
			10. Screen: Manufacturer's name Sunflower Type RMP Dia. 5" Slot gauze YB Length 49' Set between 31 ft. and 80 ft. _____ ft. and _____ ft. Gravel pack? NO Size range of material _____		
			11. Static water level: _____ mo./day/yr. 9 ft. below land surface Date 7-21-77		
			12. Pumping level below land surfaces: 43 ft. after 6 hrs. pumping 100 g.p.m. _____ ft. after _____ hrs. pumping _____ g.p.m. Estimated maximum yield 110 g.p.m.		
			13. Water sample submitted: _____ mo./day/yr. Yes <input checked="" type="checkbox"/> No <input type="checkbox"/> Date _____		
			14. Well head completion: <input type="checkbox"/> Pitless adapter <input type="checkbox"/> _____ inches above grade		
			15. Well grouted? Yes With: <input type="checkbox"/> Neat cement <input type="checkbox"/> Bentonite <input checked="" type="checkbox"/> Concrete Depth: From 0 ft. to 10 ft.		
			16. Nearest source of possible contamination: ft. 100 Direction S Type Draw in Pasture Well disinfected upon completion? <input checked="" type="checkbox"/> Yes <input type="checkbox"/> No		
			17. Pump: _____ Not installed Manufacturer's name _____ Model number _____ HP _____ Volts _____ Length of drop pipe _____ ft. capacity _____ g.p.m. Type: <input type="checkbox"/> Submersible <input type="checkbox"/> Turbine <input type="checkbox"/> Jet <input type="checkbox"/> Reciprocating <input type="checkbox"/> Centrifugal <input type="checkbox"/> Other		
18. Elevation:			20. Water well contractor's certification: This well was drilled under my jurisdiction and this report is true to the best of my knowledge and belief. Zinn Water Well Drilling 218 Business name _____ License No. _____ Address Lost Springs Kan Signed Joseph A. Zinn Date 7-22-77 Authorized representative		
19. Remarks: 					
Topography: <input type="checkbox"/> Hill <input type="checkbox"/> Slope <input checked="" type="checkbox"/> Upland <input type="checkbox"/> Valley					

T 13 S R 1 E/W
 Sec 3
 NE SE NW
 1/4 1/4 1/4

Forward the white, blue and pink copies to the Department of Health and Environment

Form WWC-5