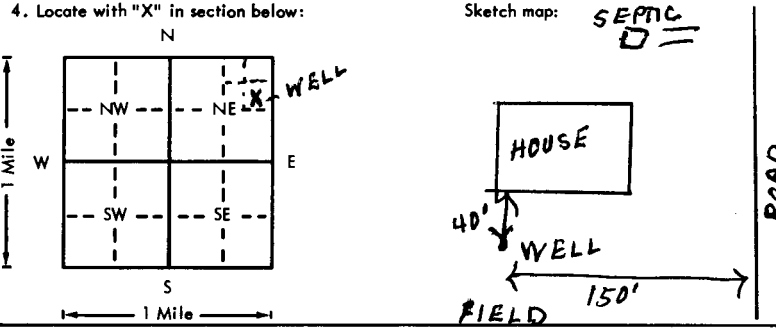
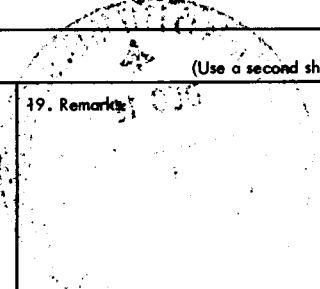


USE TYPEWRITER OR BALL POINT PEN—PRESS FIRMLY, PRINT CLEARLY.

WATER WELL RECORD
KSA 82a-1201-1215

Kansas Department of Health and Environment—Division of Environment
(Water well Contractors)
Topeka, Kansas 66620

1. Location of well:	County Dickinson	Fraction SE 1/4 NE 1/4 NE 1/4	Section number 10	Township number T 13 S	Range number R 1 E	(EW)
2. Distance and direction from nearest town or city: 4 miles west Street address of well location if in city: 1 mile north of Aiblene		3. Owner of well: Fred Veal R.R. or street: R.R. # 4 City, state, zip code: Abilene, Kansas 67410		6. Bore hole dia. <u>8</u> in. Completion date <u>1/21/77</u> Well depth <u>81</u> ft.		
4. Locate with "X" in section below: 		7. Cable tool <input checked="" type="checkbox"/> Rotary <input type="checkbox"/> Driven <input type="checkbox"/> Dug <input type="checkbox"/> Hollow rod <input type="checkbox"/> Jetted <input type="checkbox"/> Bored <input type="checkbox"/> Reverse rotary		8. Use: <input checked="" type="checkbox"/> Domestic <input type="checkbox"/> Public supply <input type="checkbox"/> Industry <input type="checkbox"/> Irrigation <input type="checkbox"/> Air conditioning <input type="checkbox"/> Stock <input type="checkbox"/> Lawn <input type="checkbox"/> Oil field water <input type="checkbox"/> Other		
5. Type and color of material		From	To	9. Casing: Material <u>Plastic RMP</u> Height: Above or below <u>5</u> in. Threaded <input type="checkbox"/> Welded <u>g1</u> Surface <u>18</u> in. RMP <input checked="" type="checkbox"/> PVC <input type="checkbox"/> Weight <u>16.3</u> lbs./ft. Dia. <u>5</u> in. to <u>81</u> ft. depth Wall Thickness: inches or Dia. <u>5</u> in. to <u>81</u> ft. depth gage No. <u>0.258</u>		
Fine sand		0	27	10. Screen: Manufacturer's name <u>Western Plastics</u> Type <u>RMP</u> Dia. <u>5 1/2</u> Slot/gauze <u>3/32</u> Length <u>26</u> Set between <u>55</u> ft. and <u>81</u> ft. <u>55</u> ft. and <u>81</u> ft.		
6/1/77 Clay and soft rock		27	81	Gravel pack? <u>Yes</u> Size range of material <u>1/16 to 3/8</u>		
				11. Static water level: <u>47</u> ft. below land surface Date <u>1/21/77</u> mo./day/yr.		
				12. Pumping level below land surfaces: <u> </u> ft. after <u> </u> hrs. pumping <u> </u> g.p.m. <u> </u> ft. after <u> </u> hrs. pumping <u> </u> g.p.m. Estimated maximum yield <u>16</u> g.p.m.		
				13. Water sample submitted: <u> </u> mo./day/yr. Yes <input type="checkbox"/> No <input checked="" type="checkbox"/> Date <u> </u>		
				14. Well head completion: Pitless adapter <u>18</u> inches above grade		
				15. Well grouted? <u>Yes</u> With: <input checked="" type="checkbox"/> Neat cement <input type="checkbox"/> Bentonite <input type="checkbox"/> Concrete Depth: From <u>0</u> ft. to <u>10</u> ft.		
				16. Nearest source of possible contamination: <u>Septic Tank</u> ft. <u>200</u> Direction <u>NE</u> Type <u>Tank</u> Well disinfected upon completion? <input checked="" type="checkbox"/> Yes <input type="checkbox"/> No		
				17. Pump: <input checked="" type="checkbox"/> Not installed Manufacturer's name <u> </u> HP <u> </u> Volts <u> </u> Length of drop pipe <u> </u> ft. capacity <u> </u> g.p.m. Type: <input type="checkbox"/> Submersible <input type="checkbox"/> Turbine <input type="checkbox"/> Jet <input type="checkbox"/> Reciprocating <input type="checkbox"/> Centrifugal <input type="checkbox"/> Other		
18. Elevation:		(Use a second sheet if needed)		20. Water well contractor's certification: This well was drilled under my jurisdiction and this report is true to the best of my knowledge and belief. <u>Rader Drilling Co.</u> 194 Business name <u>Carlton, Kansas</u> License No. <u>67429</u> Address <u> </u> Signed <u>Brent E. Rader</u> Date <u>3-11-77</u> Authorized representative		
19. Remarks: 						
Topography: <input type="checkbox"/> Hill <input type="checkbox"/> Slope <input type="checkbox"/> Upland <input type="checkbox"/> Valley						

Forward the white, blue and pink copies to the Department of Health and Environment

Form WWC-5